See letter to Belfast
20.11.93.

Longitudinal Elevation of S.S. No. 109 "Logician"

Scale 1/8 inch = one foot.

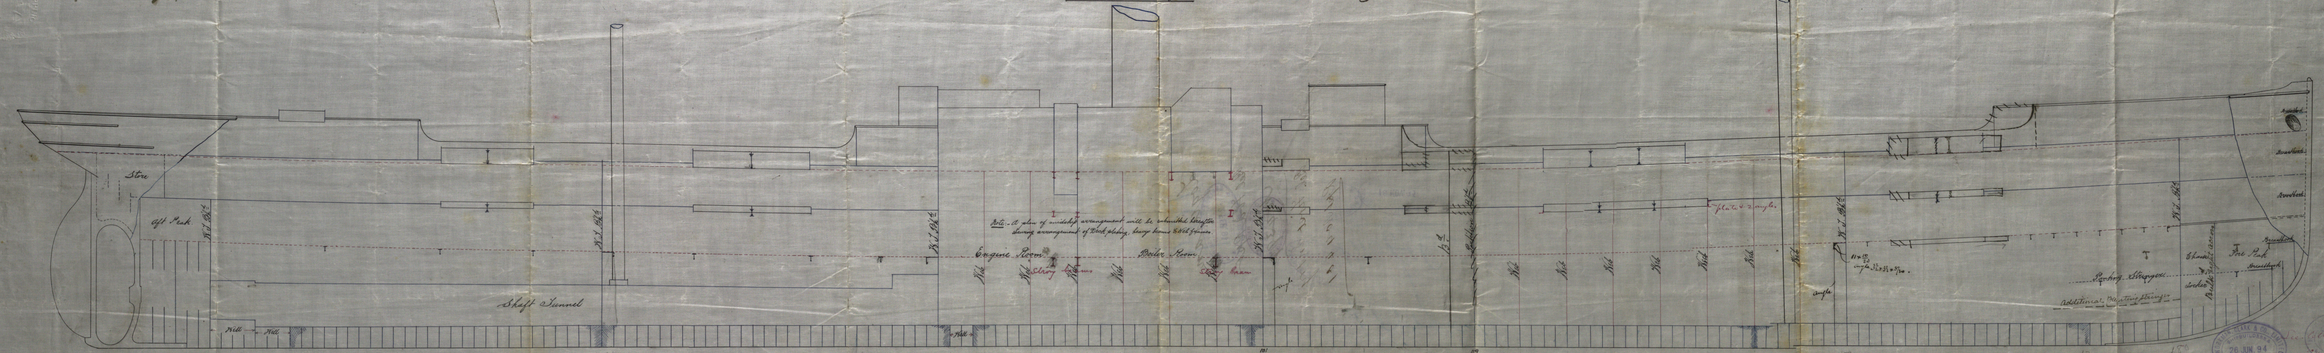
Store
Aft Peak
Shaft Tunnel
Engine Room
Boiler Room
Fore Peak
Anchor
Bowsprit
Plate & Angle
Stores

BEL64-0018

Logician

LLOYD'S REGISTER OF SHIPPING RECEIVED 2 FEB. 91 LONDON

Bel Hd Rpt

LLOYD'S REGISTER BELFAST OF SHIPPING

No 4399

Bel. First Entry

Rpt No 4401

LLOYD'S REGISTER 18 NOV 23

© 2019 Lloyd's Register Foundation