



6.2.94.

Midship Arrangement of Beams & Deck Plating No 109. S.S.
 Scale 1/4 inch = 1 foot

Upper Deck

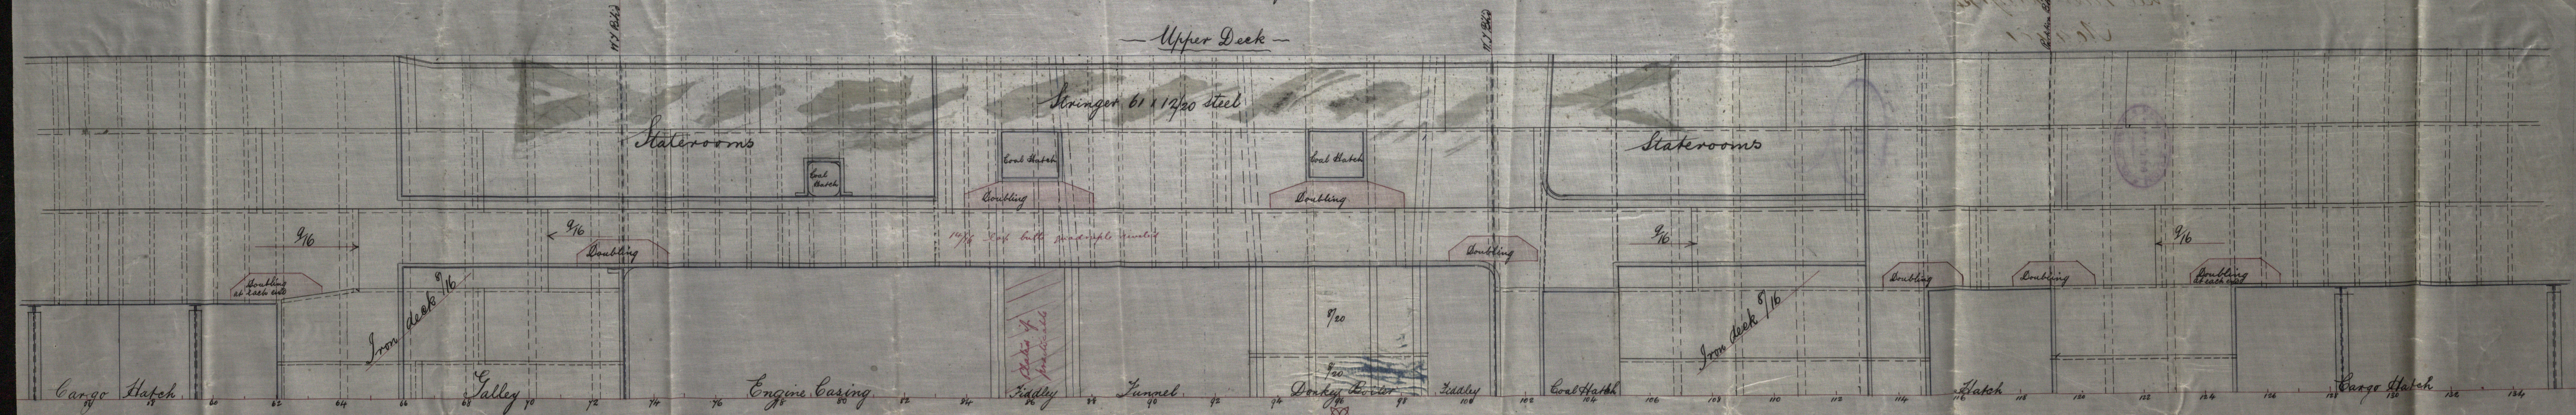

Main Deck

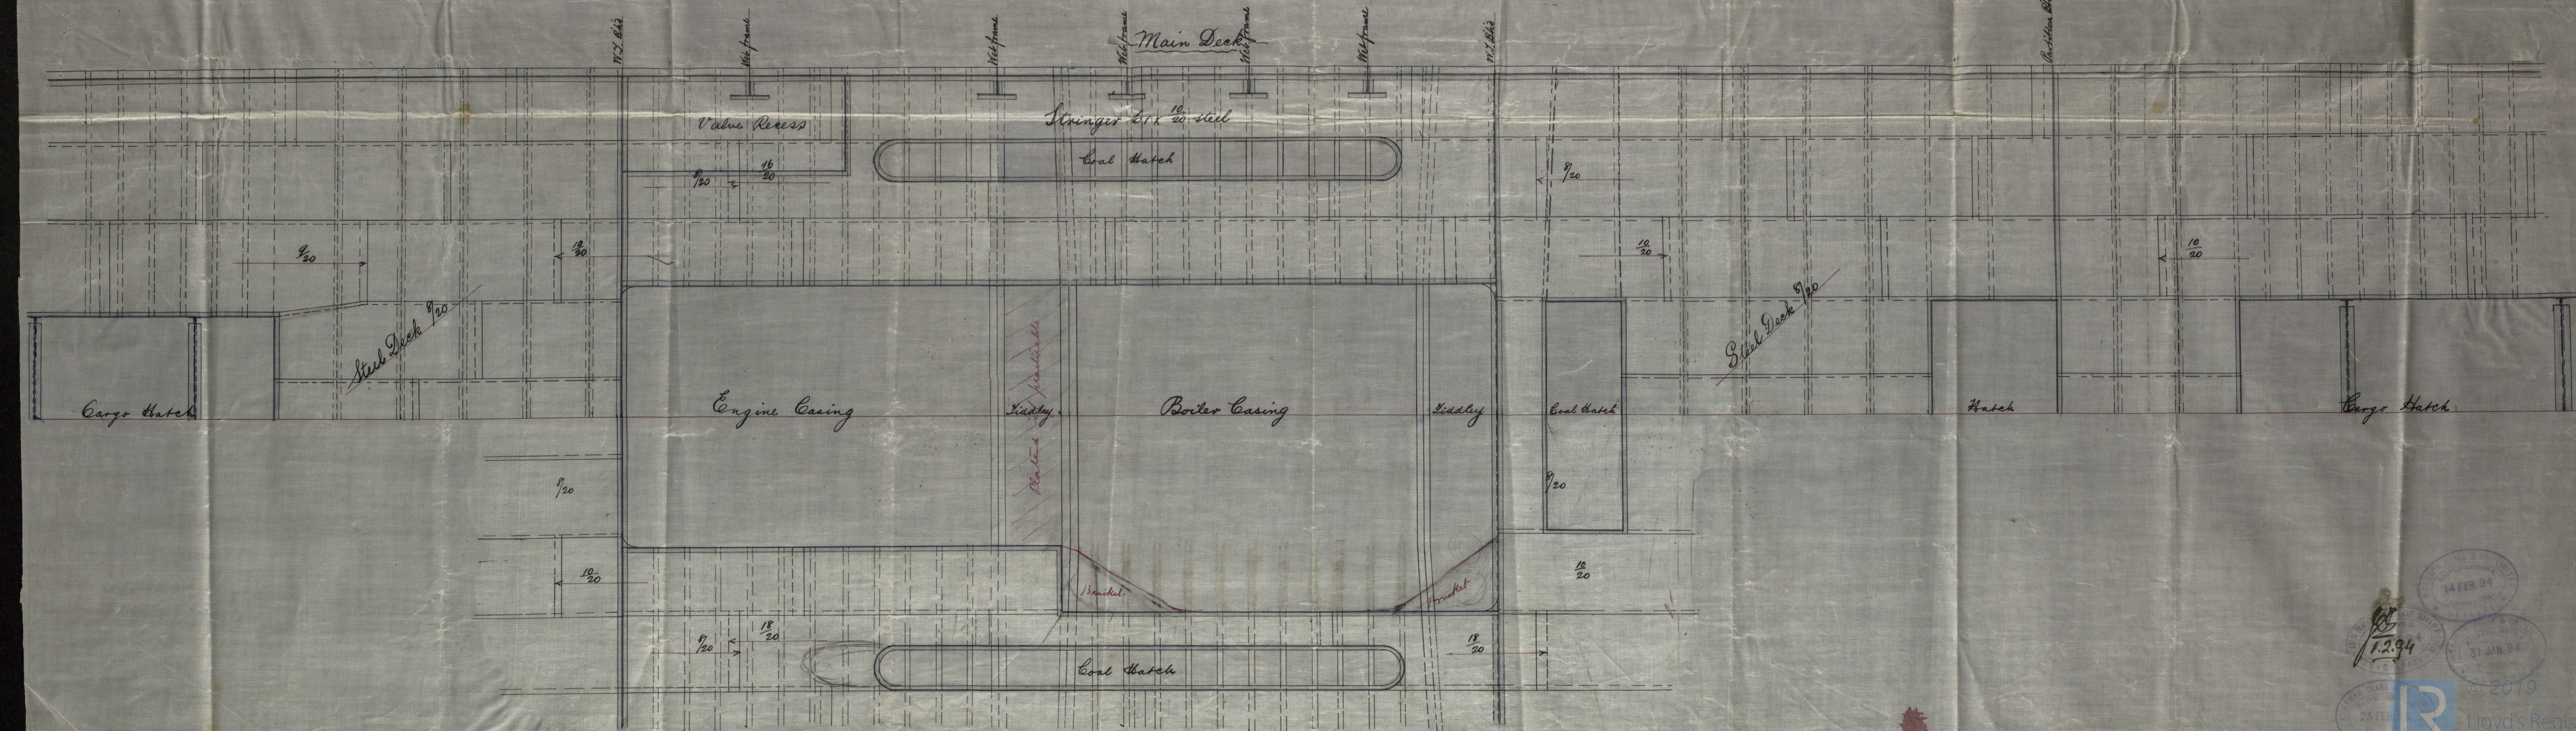

1.2.94
 14 FEB 94
 31 JAN 94

Logician

Rel First Entry Rpt

No 4401



Deck



© 2019

Lloyd's Register
Foundation