
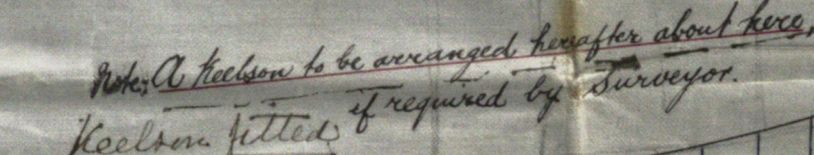


— Longitudinal Elevation of No. 110 Screw Steamer — and No. 112
— Scale $\frac{1}{8}$ inch = 1 foot. — No. 110. "Ching Wo."



Lloyd's Register Foundation

BEL 64-0032 Foundation

BEL64-0031

BELFAST

Ching Wo.

Bel. Rpt No 4413

Profile

Bel. 25/12/93
Rpt No 4329

LLOYD'S REGISTER OF SHIPPING
RECEIVED
19 MAY. 94
LONDON

© 2019
LLOYD'S REGISTER OF SHIPPING
RECEIVED
23 MAY 94
LONDON

Lloyd's Register
Foundation