



22.12.93.  
5.5.94

Midship Section of No. 110 Screw Steamer

— To Class 100 A1 3 Decks Steel —


— Scale  $\frac{1}{2}$  inch = 1 foot —

and No. 112  
No. 110 "Ching Wo."

Bridge deck

Upper deck

Main deck

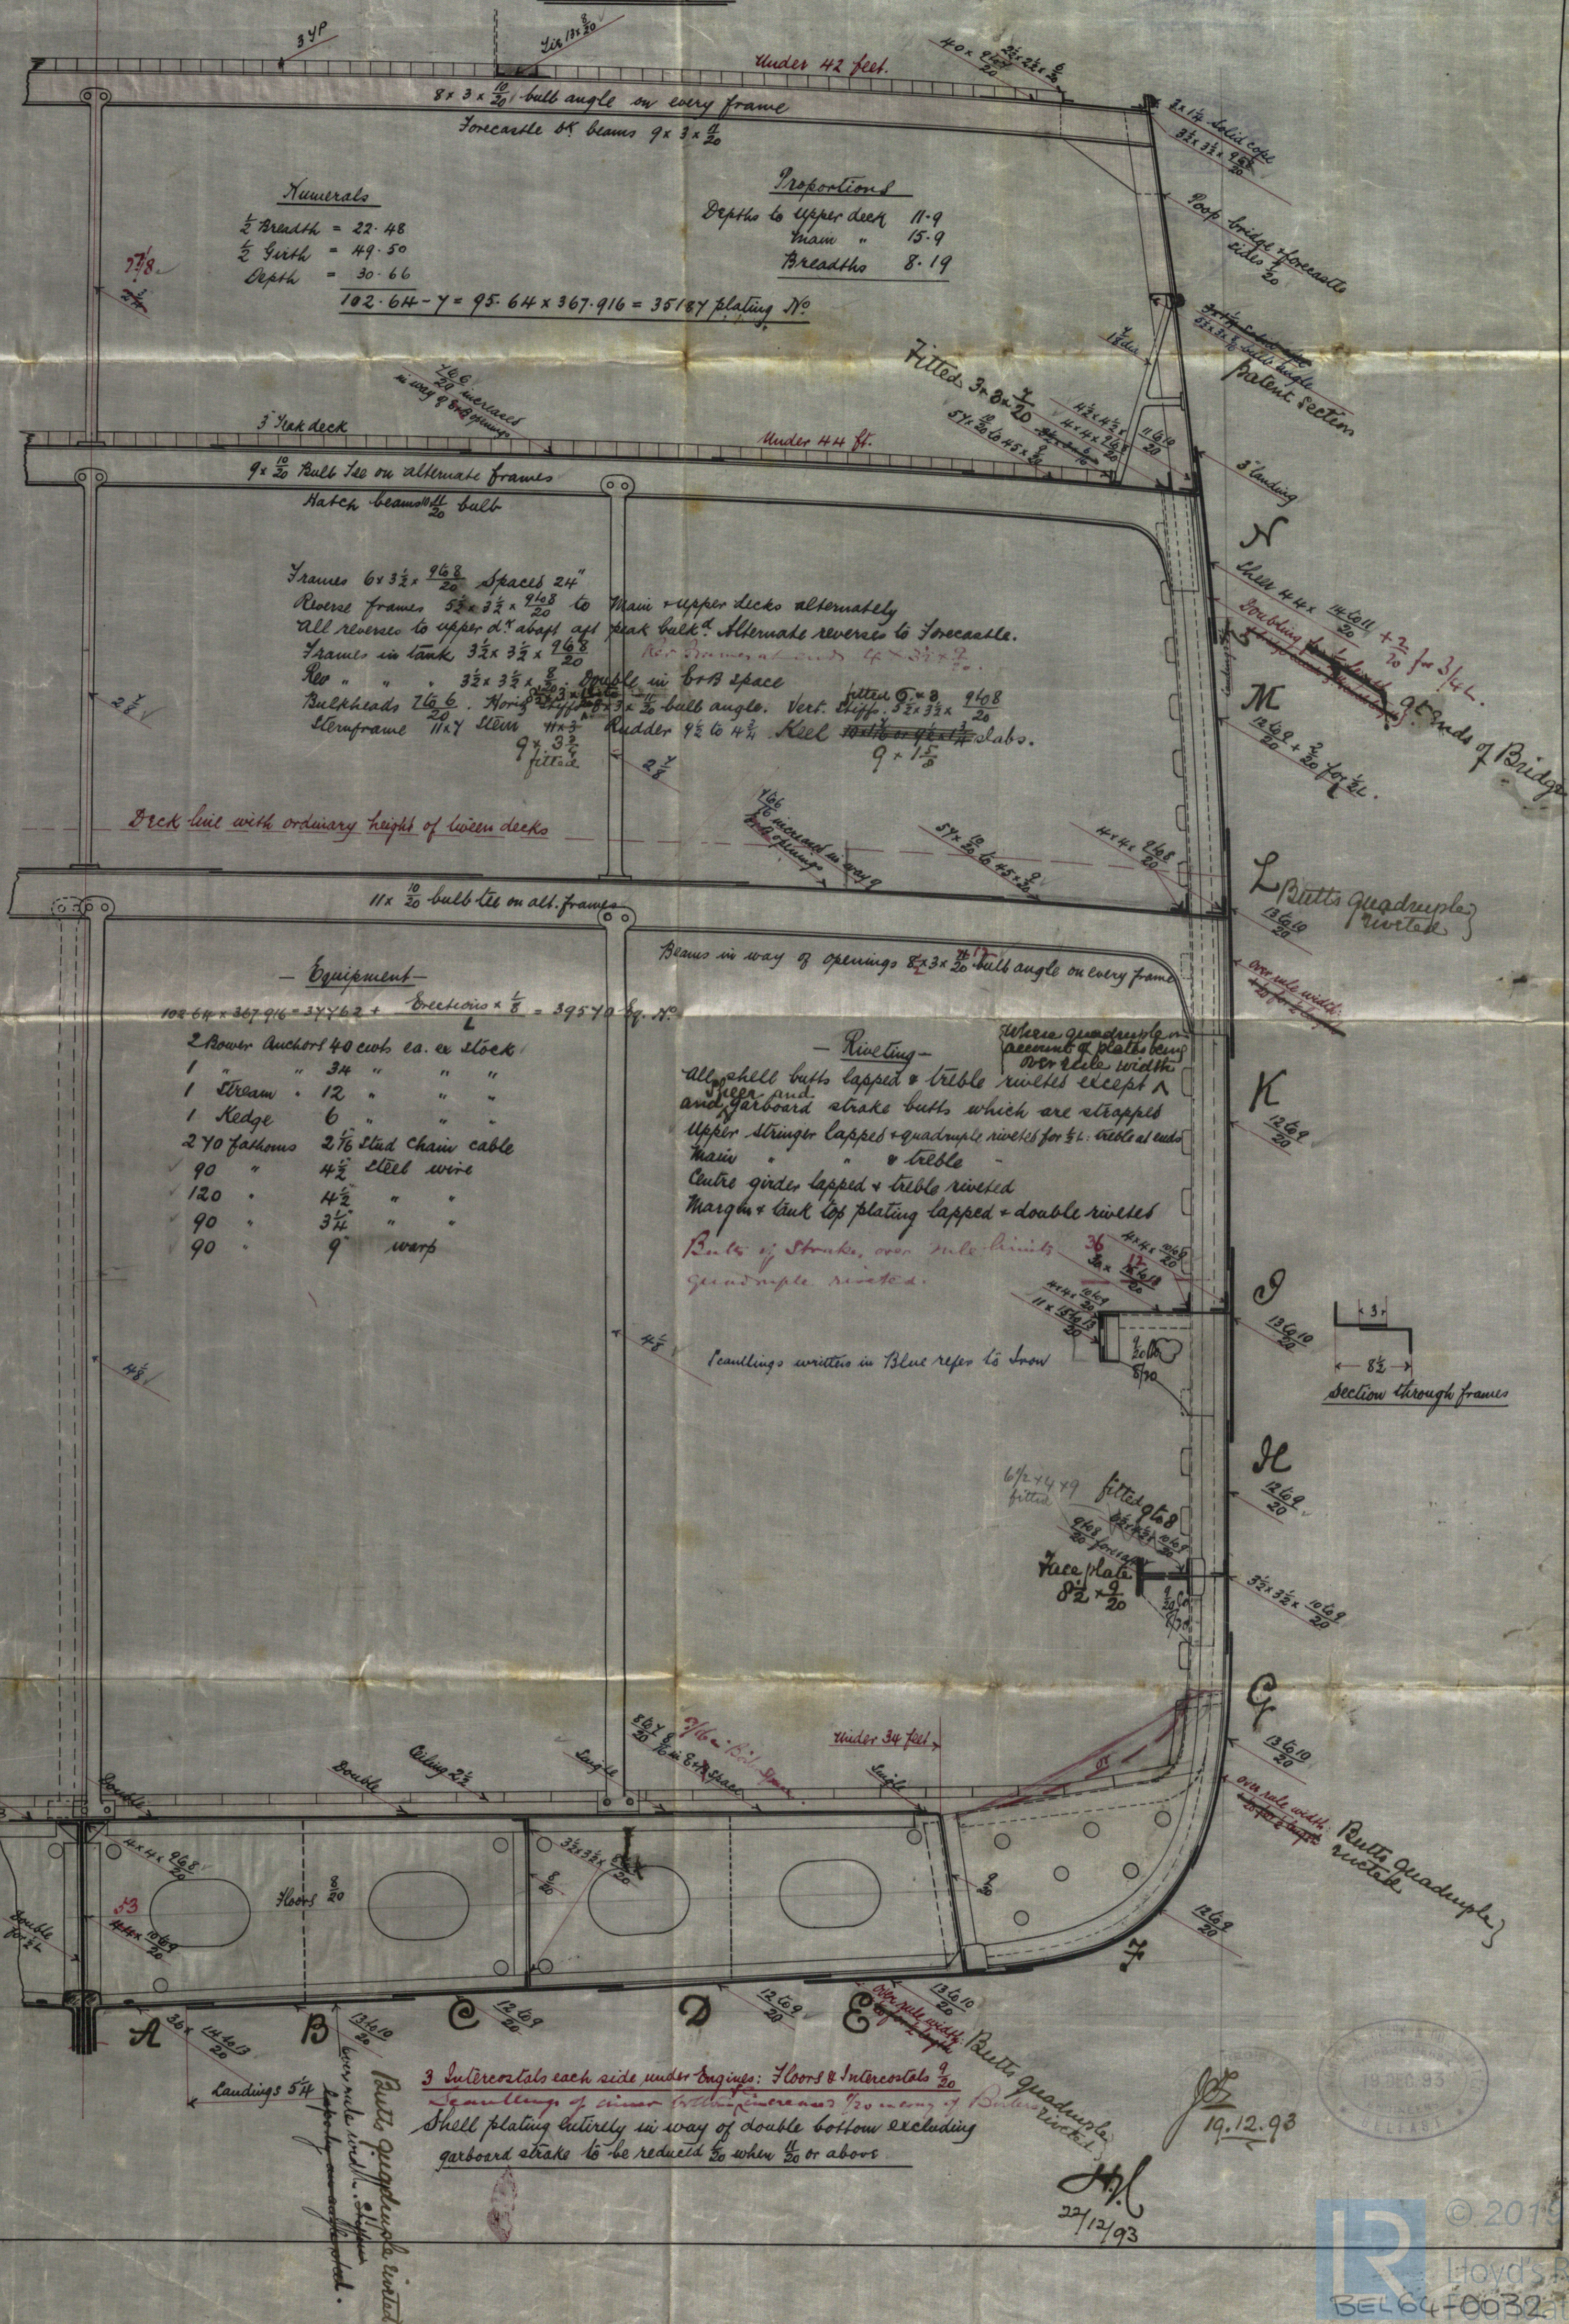




Ching W<sup>o</sup>  
Bel 4415

1990

"Lenny" - 01/98  
Midship

Bel. Freed. and Opl.

CLYDE REGISTER OF SH  
RECEIVED  
25 MAY 94

© 2019

Lloyd's Register  
Foundation