



25.4.94

Arrangement of Midship Beams & Plating Nos 110 & 112 S.S.


Scale 1/4 inch = 1 foot.

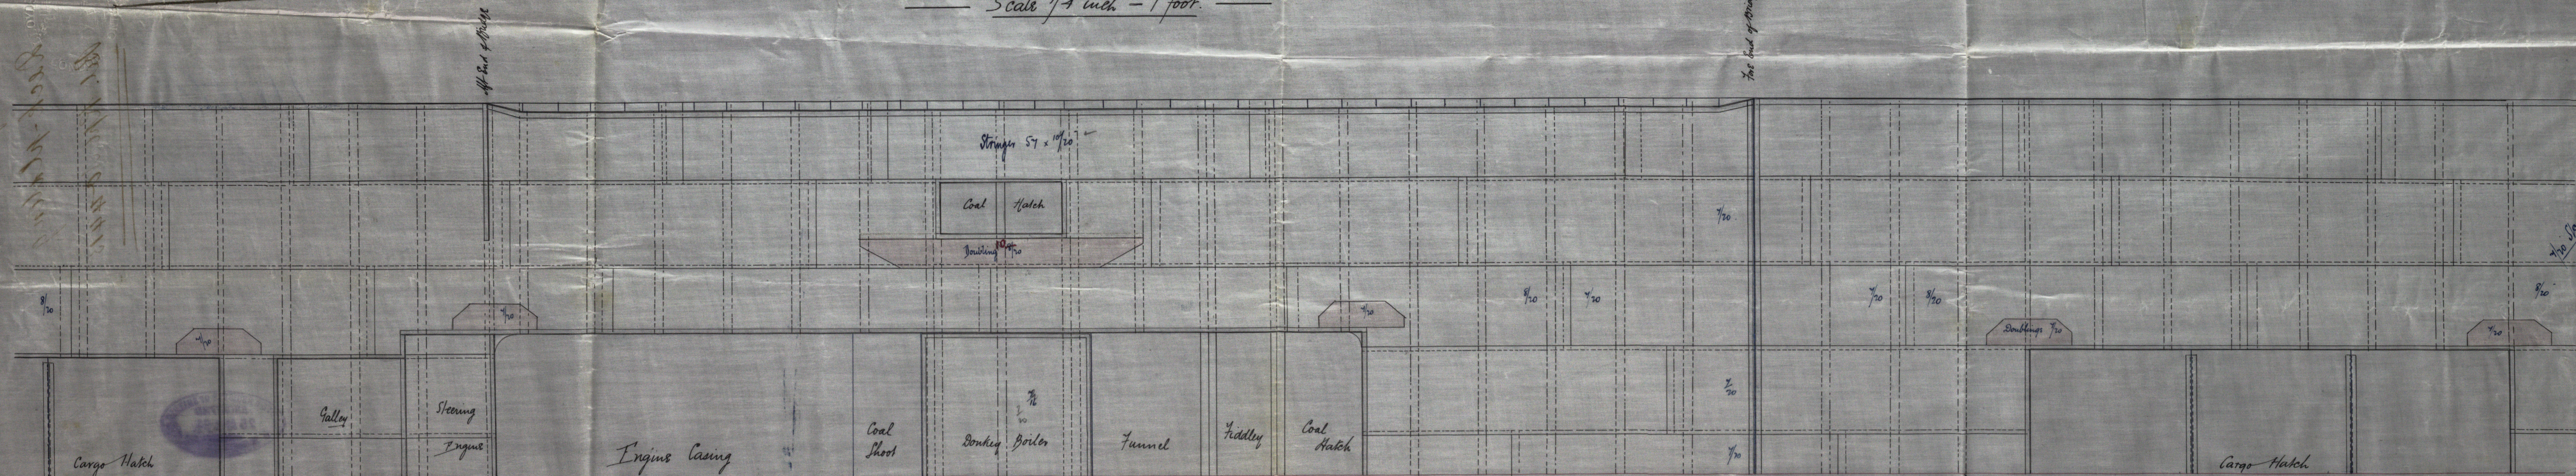

Upper Deck

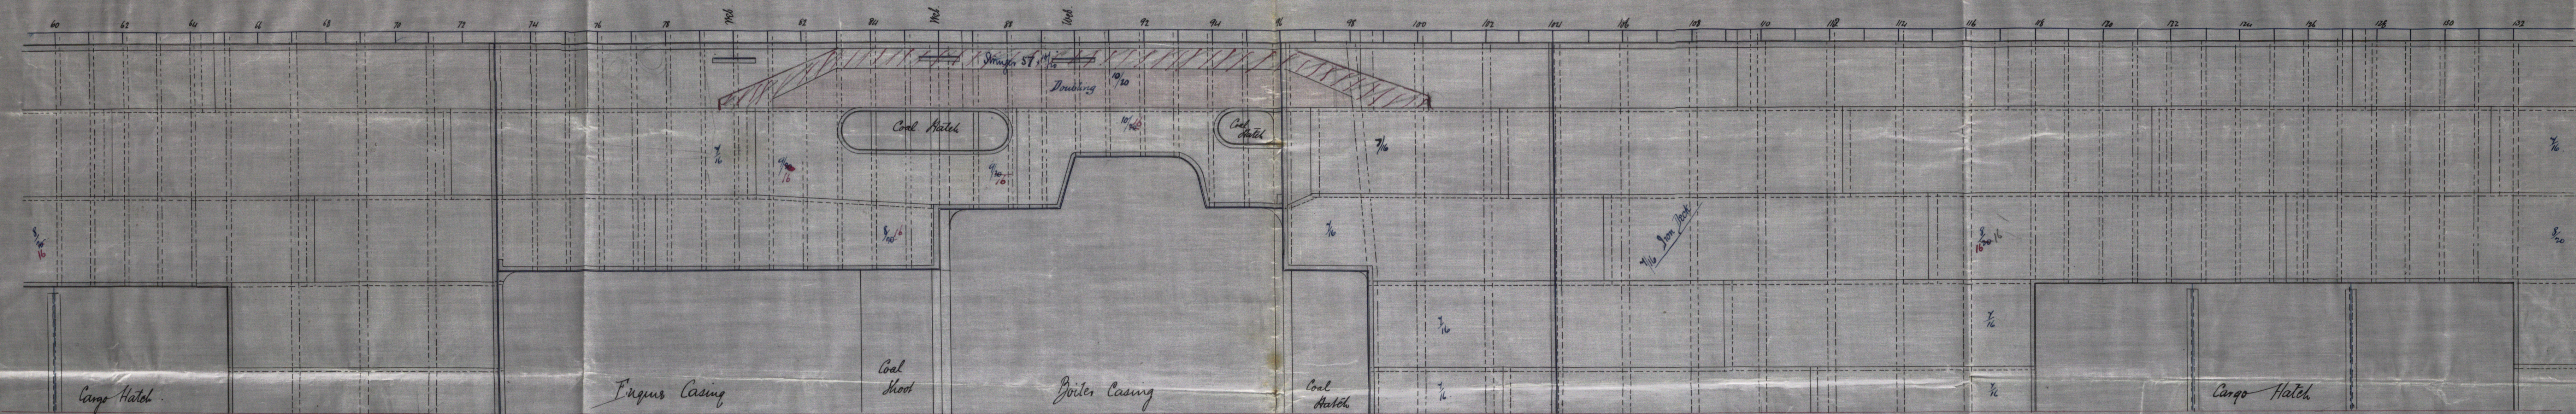

Main Deck

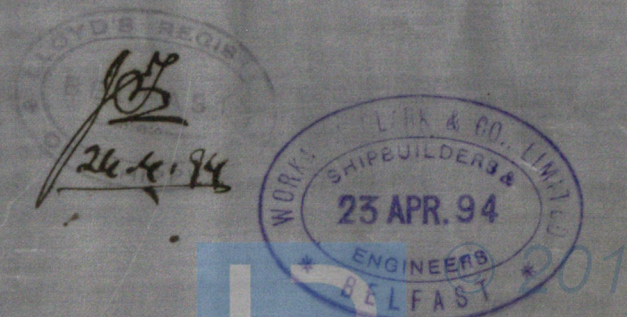

BEL64-033

Ching Wo

Deck-plating

Bel. Rpt No 4415

11/17/94
Deck plating



Canada House

2/10/94

2/10/94

2/10/94



Lloyd's Register
Foundation