


22.5.94

Plan showing Section of Side Stringers $N^{\circ} 105 + 110$ S.S.
Scale $\frac{1}{2}'' = \text{one foot}$



$N^{\circ} 105$ S.S.
 $359.16 \times 44.3 \times 29.97$ Plating $N^{\circ} 33.645$

$N^{\circ} 110$ S.S.
 $367.91 \times 44.96 \times 30.66$ Plating $N^{\circ} 35.185$

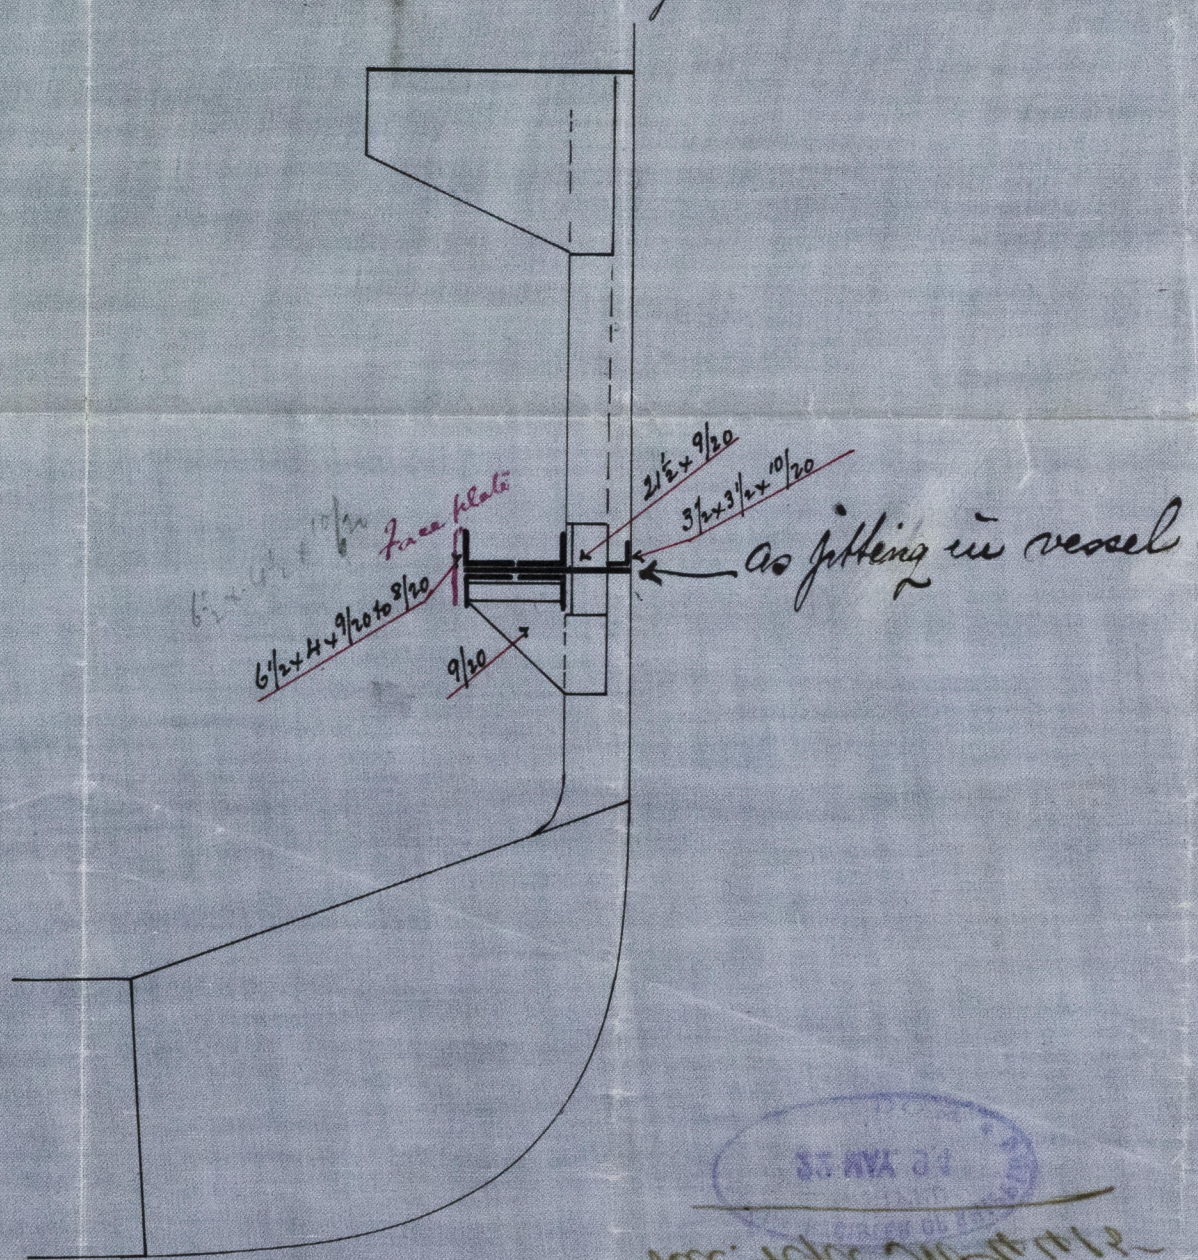

Ching Wo

Side stringers
Bel. Rpt No 4415

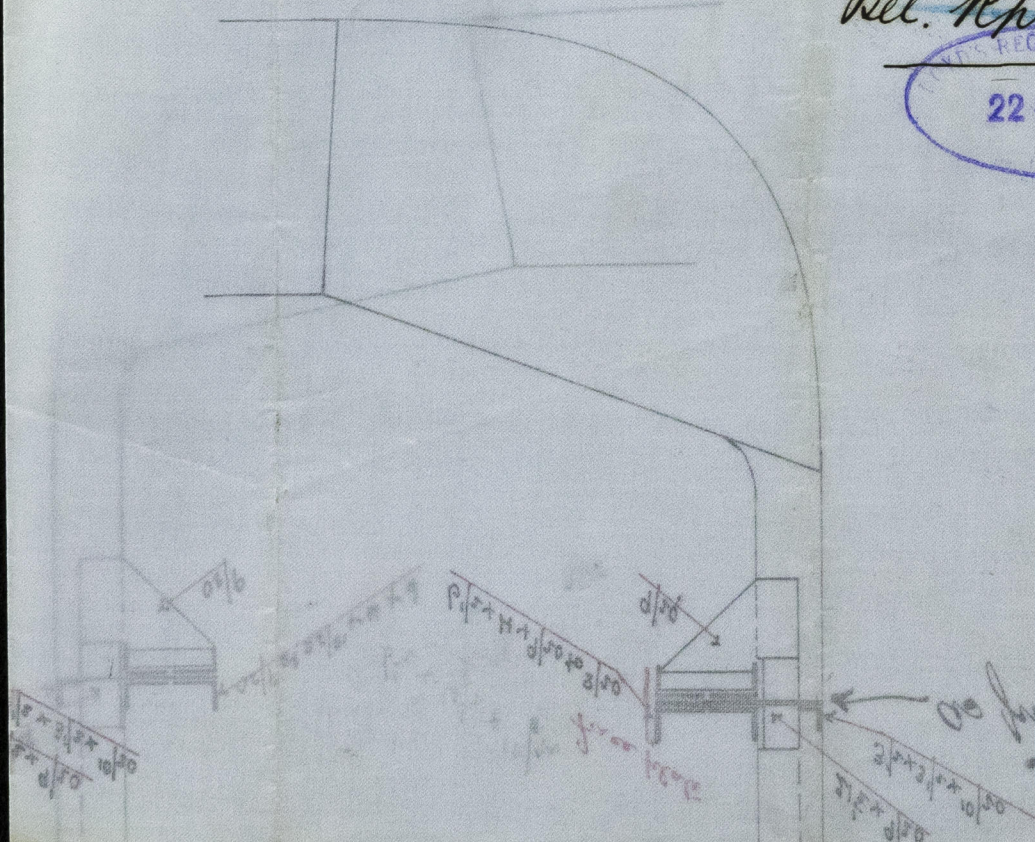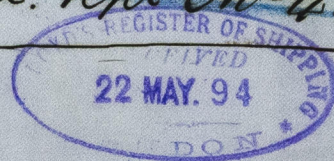

© 2019

Lloyd's Register
Foundation