


P 34'
B 88
7 74

N^o 113

Scale $\frac{1}{8}" = \text{one foot}$

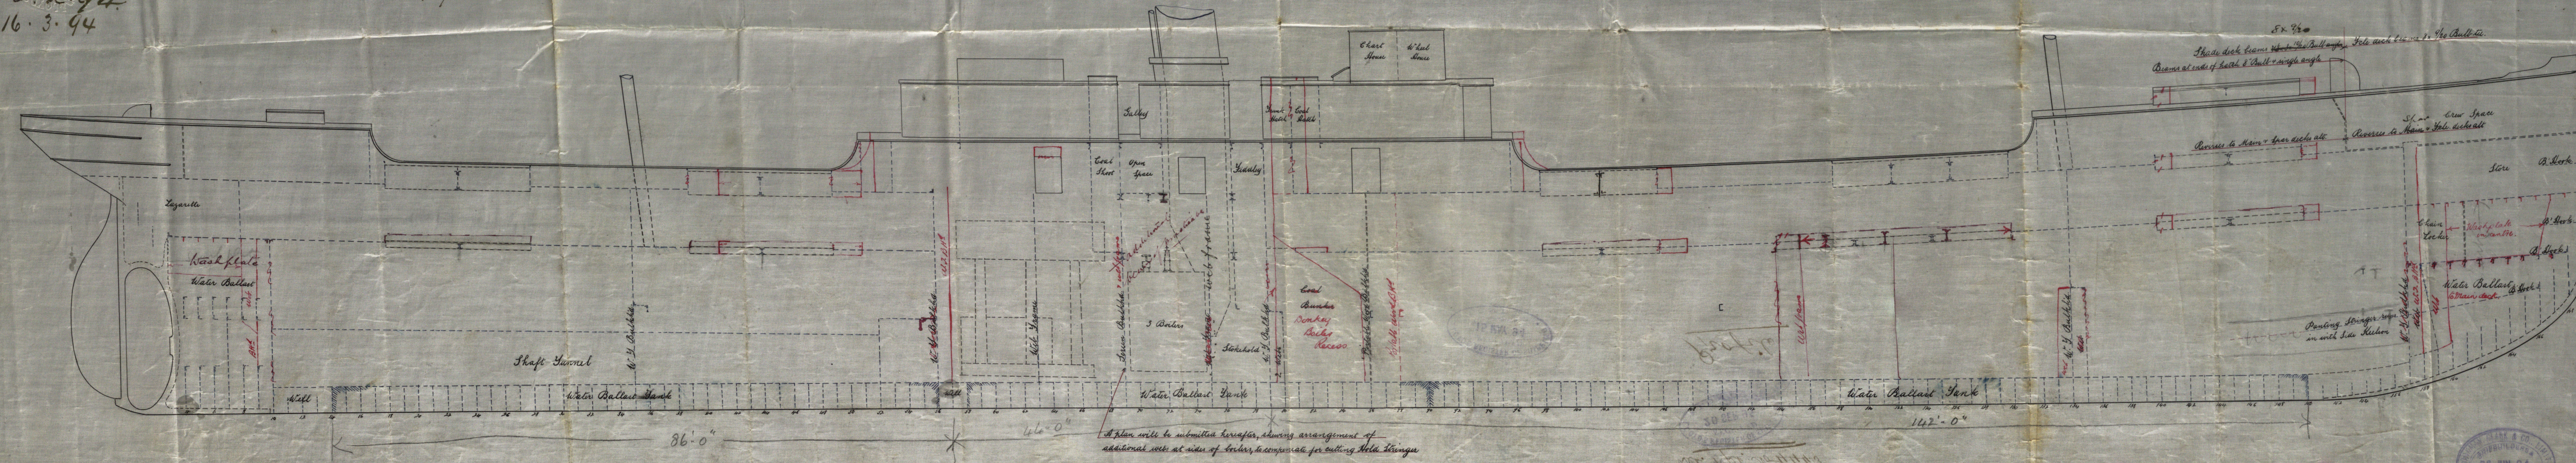

A plan will be submitted hereafter, showing arrangement of additional web at sides of bolsters, to compensate for cutting Gold Stinger



© 2019
Lloyd's Register
Foundation

BEL 64-0113

"Wimston Grange"

Bel. Rpt. No 4443



Profile



© 2019

Lloyd's Register
Foundation