

LOYDS REGISTER OF SHIPPING

17.5.94

3 1/2 ft. p. main topmast
the topmast an additional
8 ft. into the main mast

about 10 ft. 8 in.

Sail Plan No 113 S.S.

Scale 1/8" = one foot.

10 JUL 94
20 MAR 94
20 MAR 94

3 1/2 ft. p. main topmast
the topmast an additional
8 ft. into the main mast

Unmasted 8 ft.

W. & A. CLARK & CO. LIMITED
SHIPBUILDERS
26 APR. 94
ENGINEERS
BELFAST

BEL64-0116



© 2019
Lloyd's Register
Foundation

BEL64-0116

Wimston Grange
Sail plan

Bel. Rpt. No 4443

Sail plan

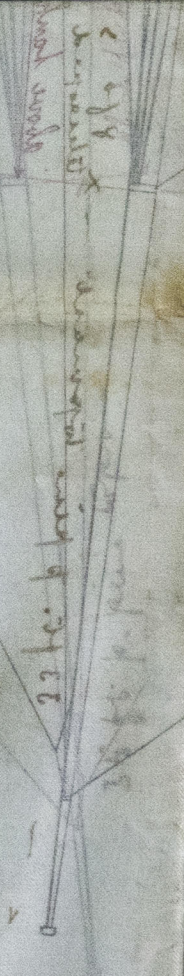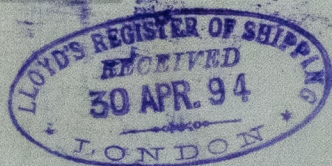

© 2019

Lloyd's Register
Foundation