


TRACING N^o 1503

MAIN BOILER N^o 12
FURNACE FRONTS

ALTERATION TO RIVETING

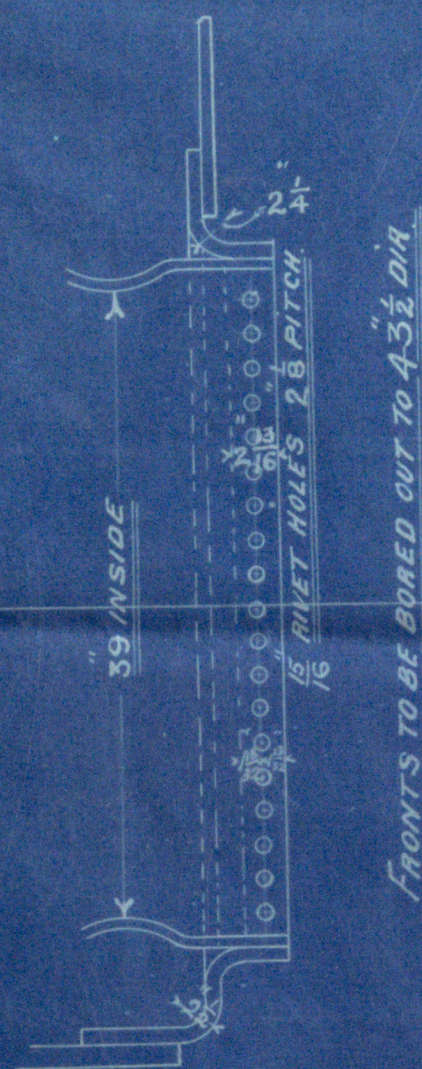

SCALE 1" = 1 FOOT.

MLD.



BEL 64-0118