


Rev. Mr. 5.94

Pumping Arrangement - No 113 S.S.
Scale 1/8 inch = 1 foot.

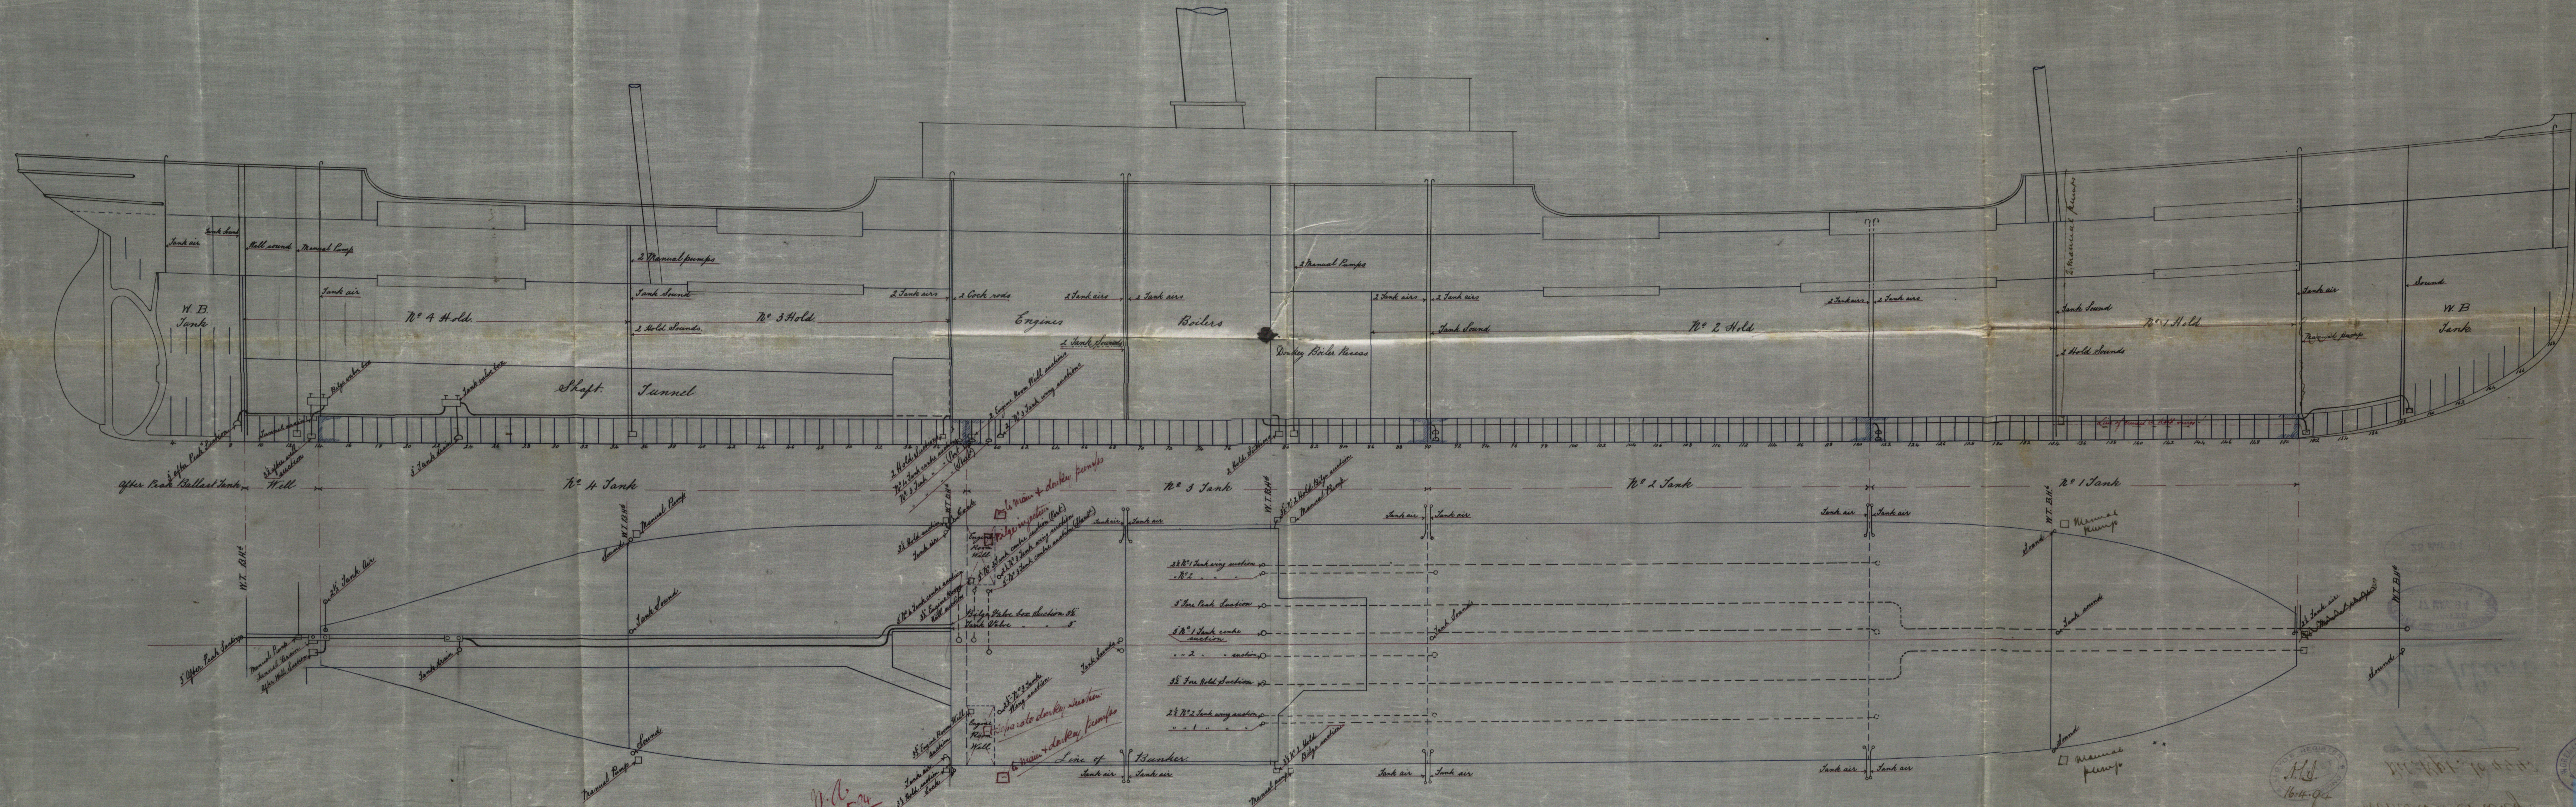

16 MAY 94
Lloyd's Register
104-94



Wmston Grange

BEL 64-0120

Bel. Rpt. No 4443

113

Ripe plan

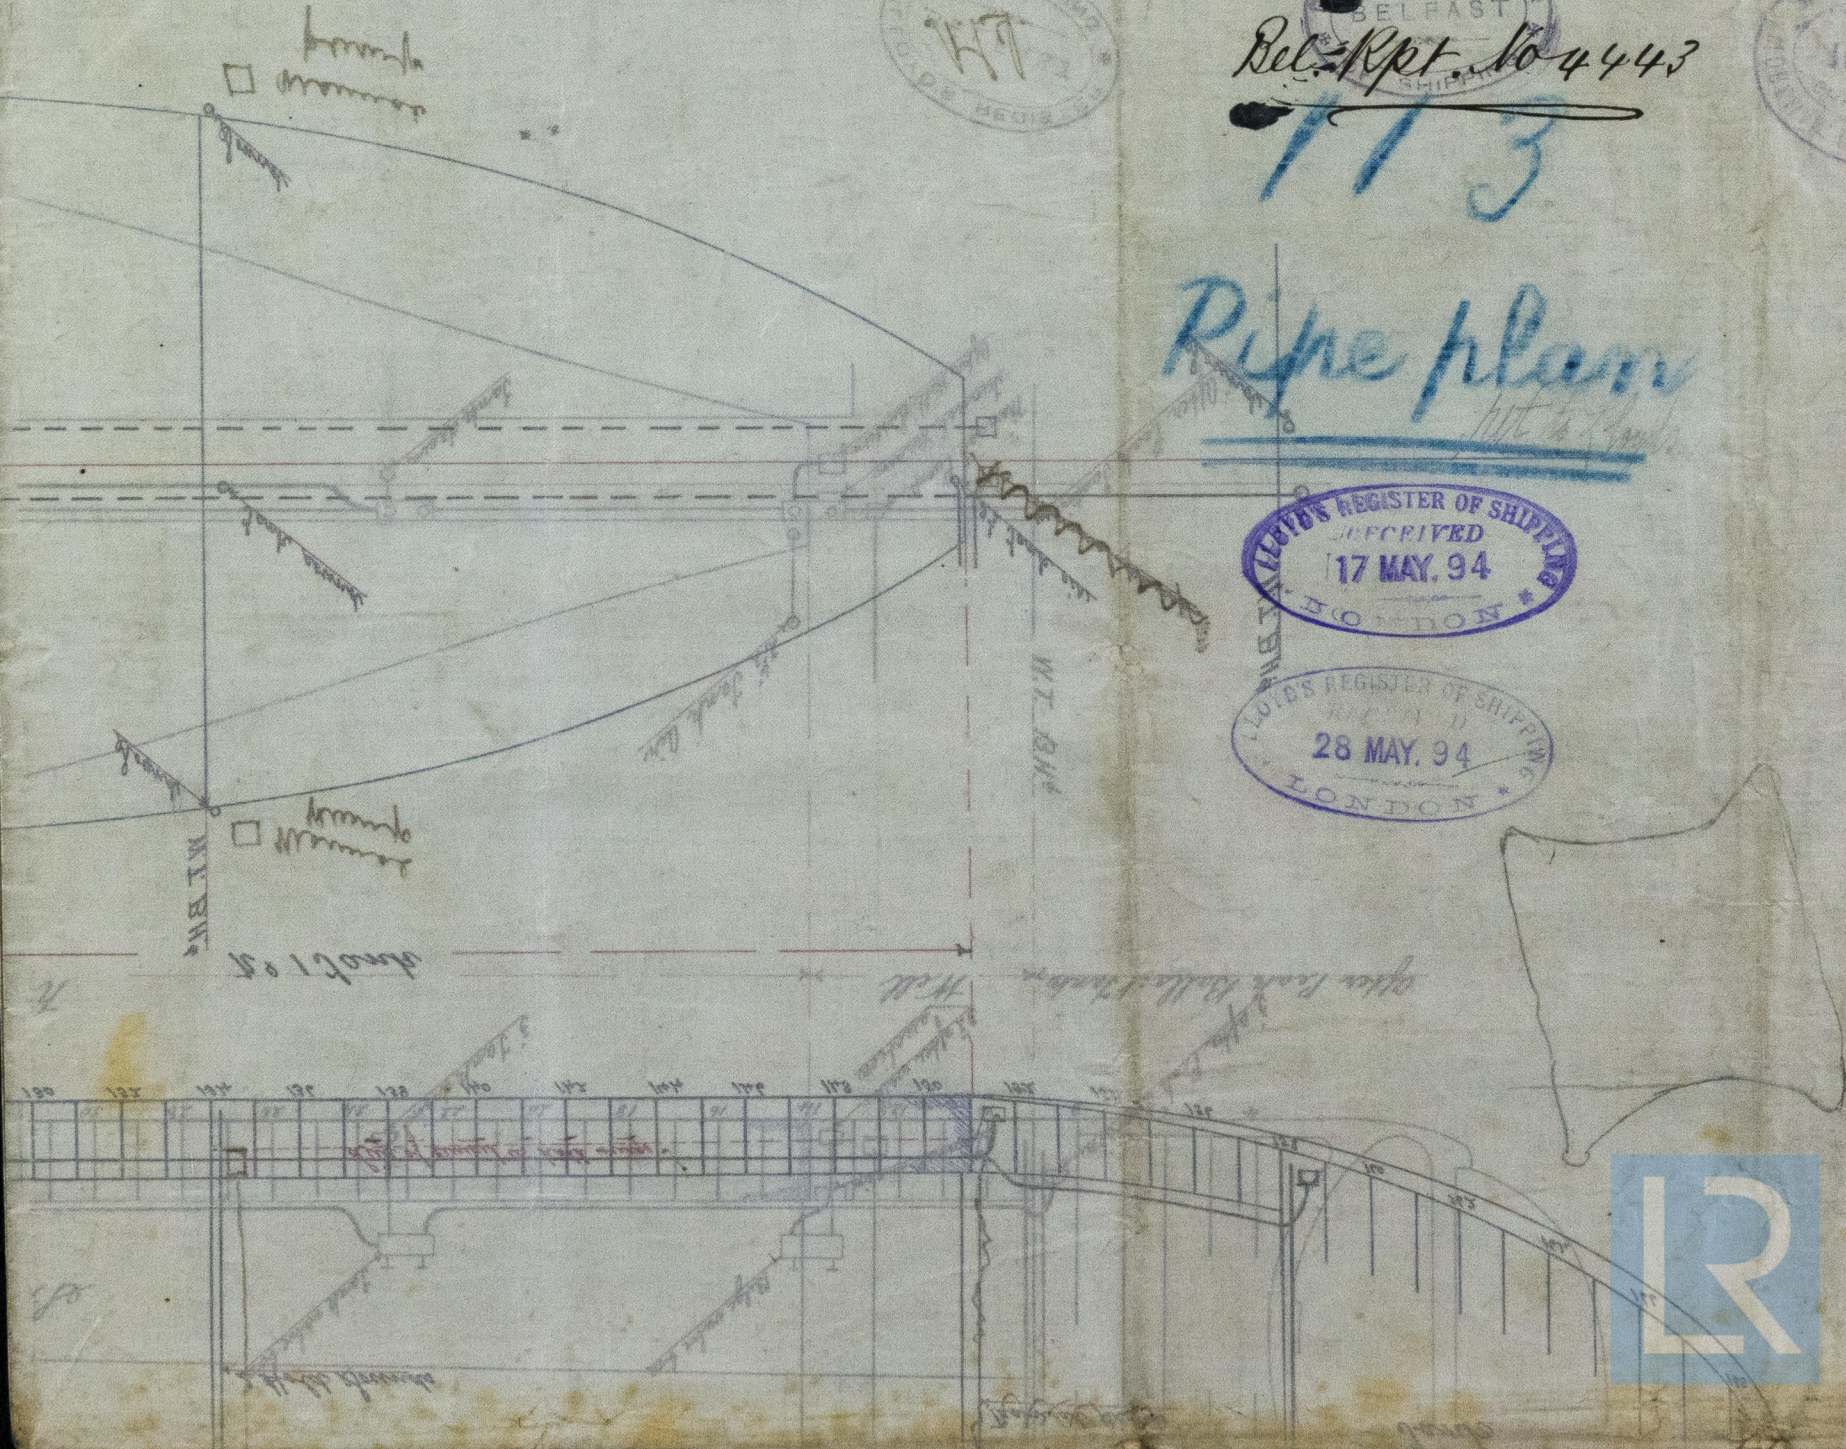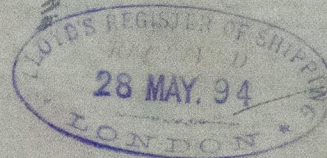

© 2019

Lloyd's Register
Foundation