



Stepping of Masts No 113 S.S.

Scale $\frac{1}{4}$ " = one ft.

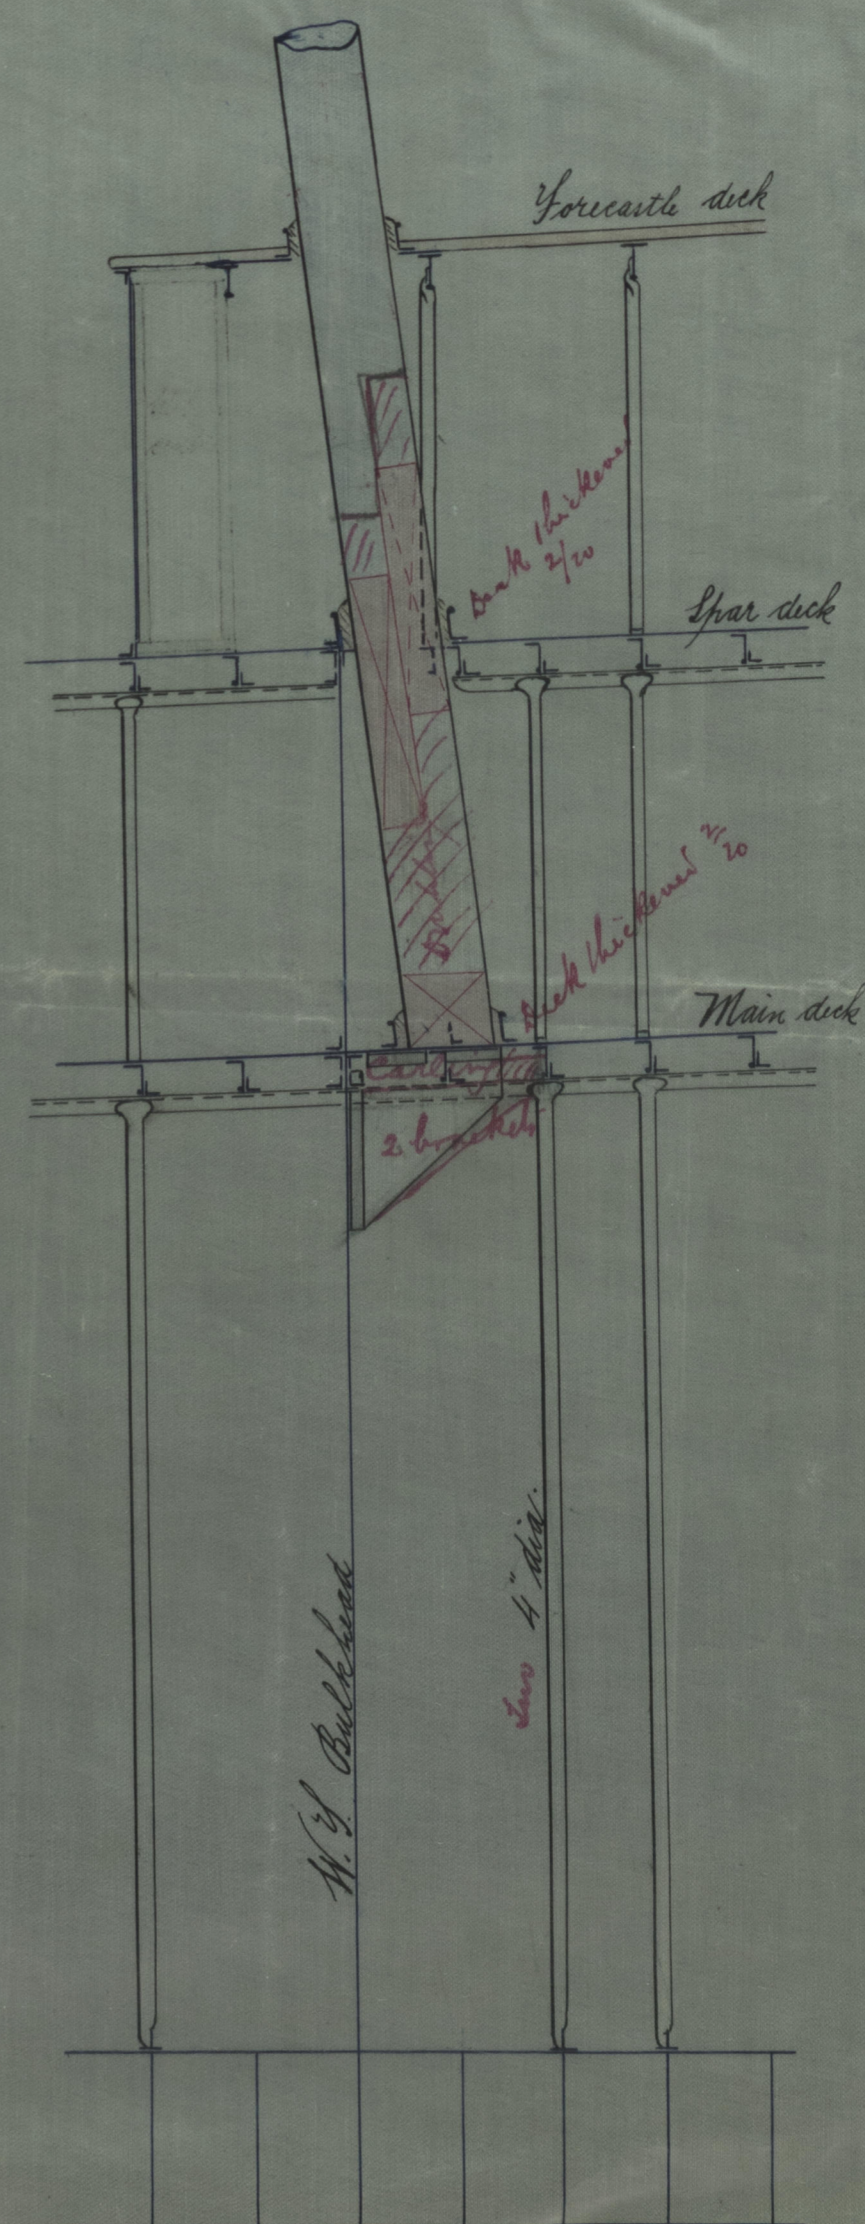

- Fore Mast

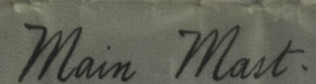


BEL64-0121

Wimston Grange

Maat step


Del Rpt. No 4443

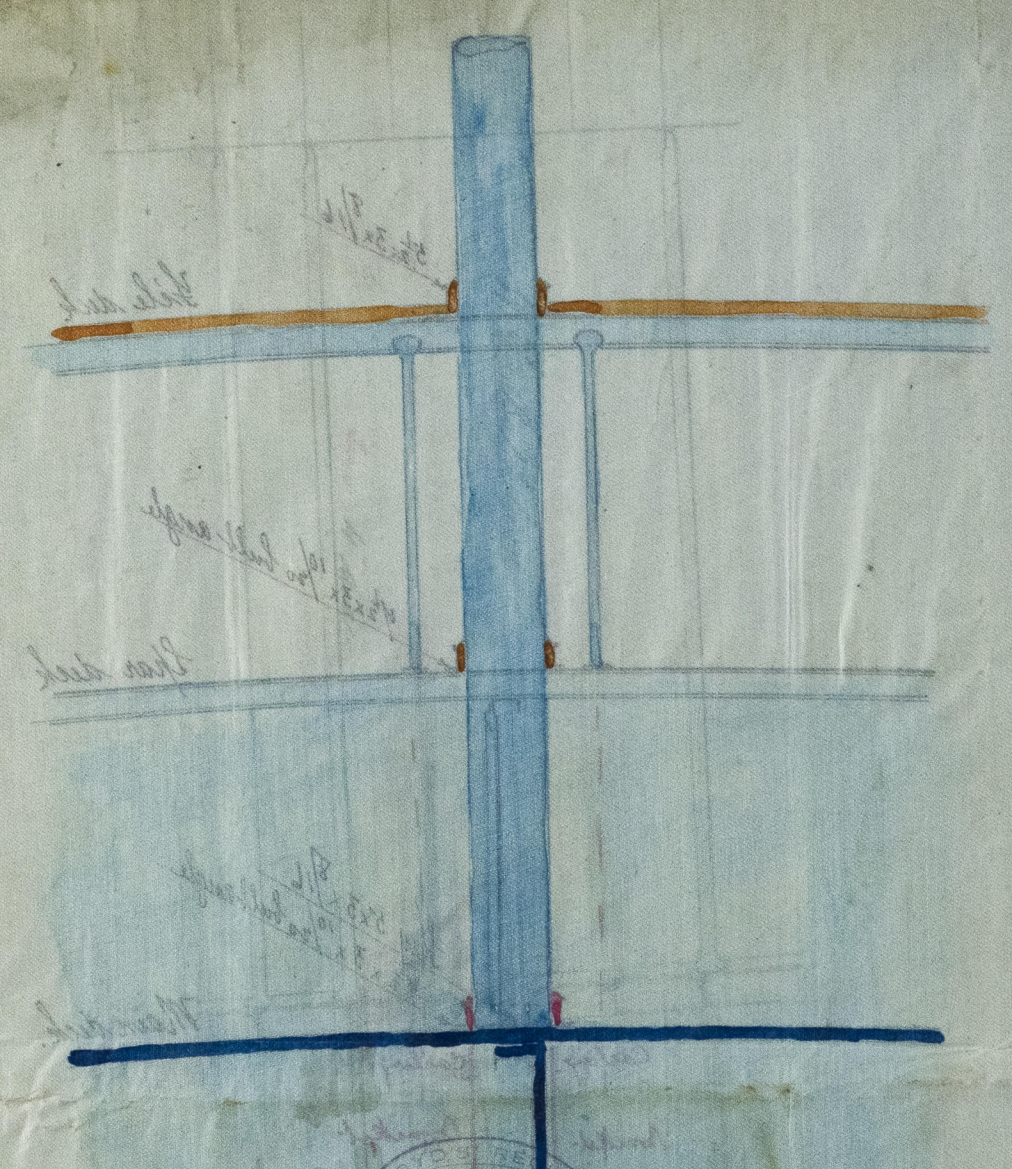

No 113
Steppings of Maat

LLOYD'S REGISTER OF SHIPPING
16 MAY. 94
LONDON

LLOYD'S REGISTER OF SHIPPING
16 MAY. 94
LONDON

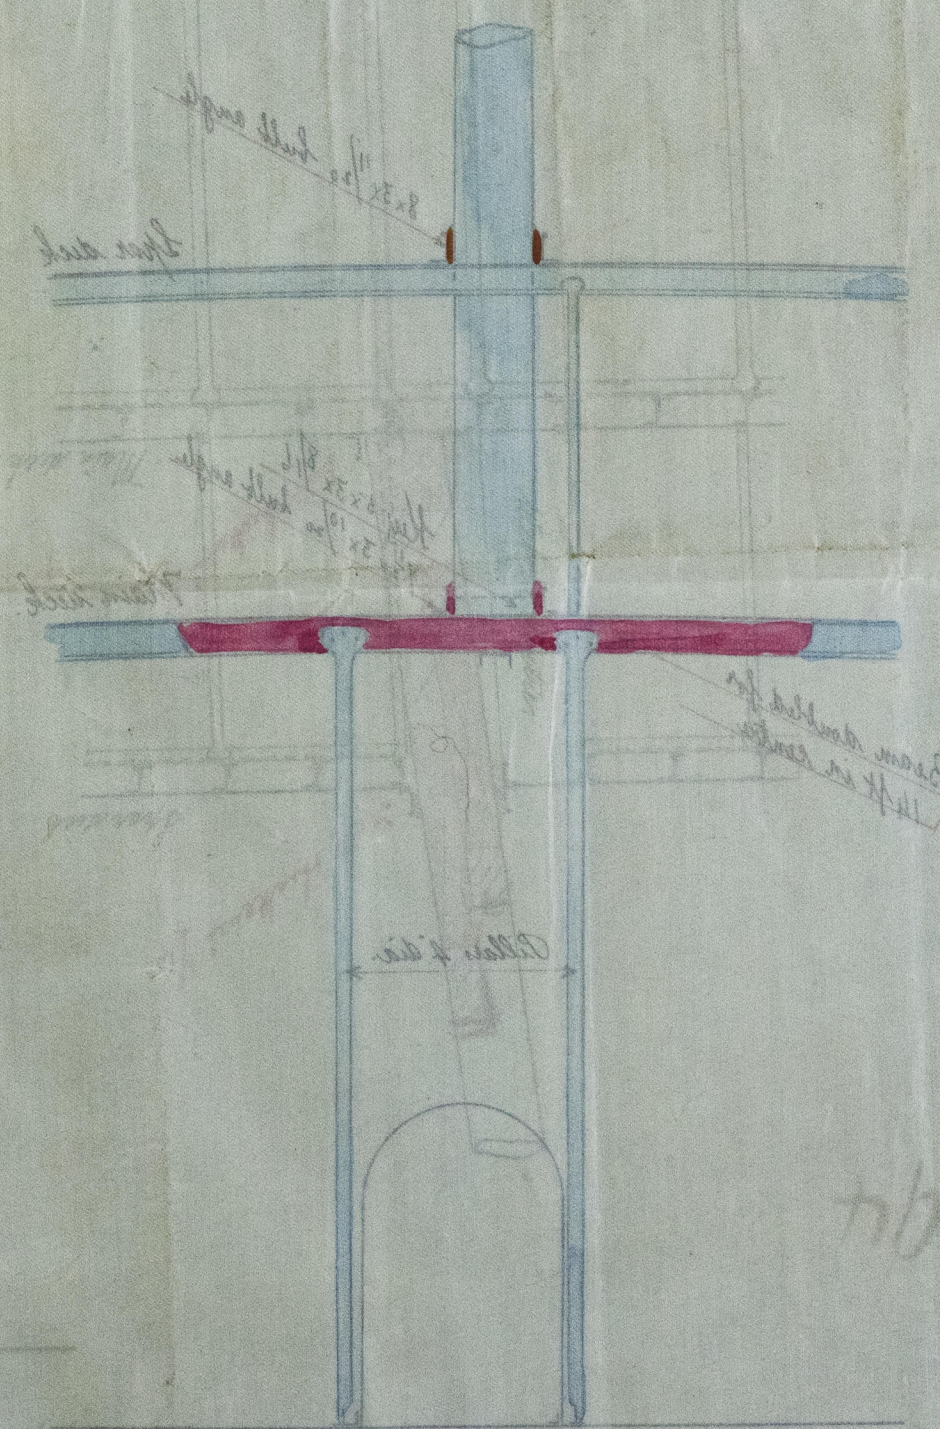

17.5.94

