





17.5.94

Arrangement of Midship Beams & Deck Plating N^o 113 S.S.

Scale 1/4 inch = one foot.

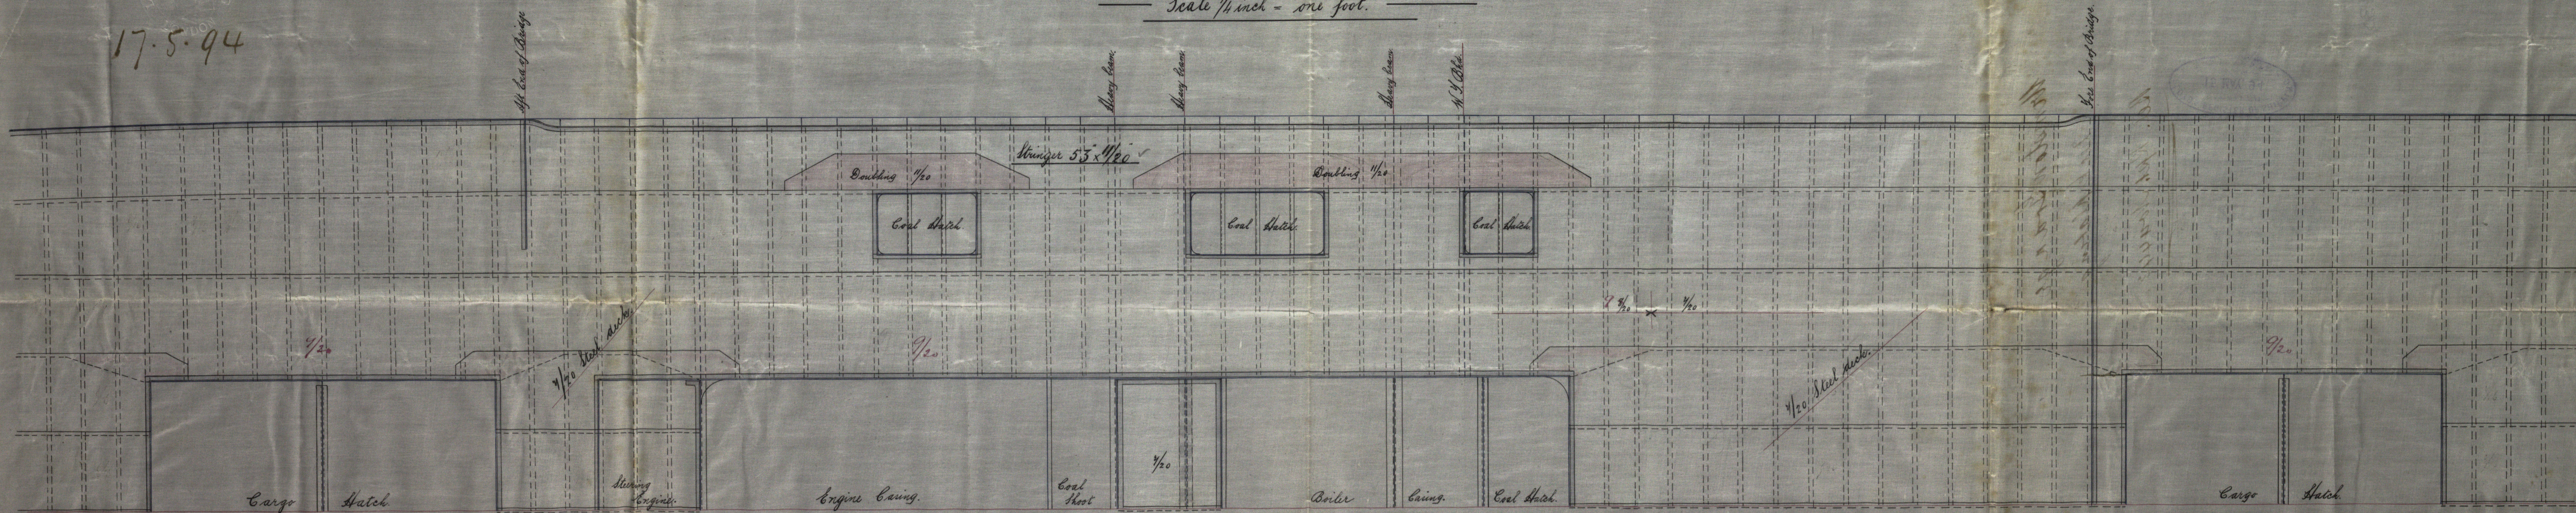

Spar Deck.

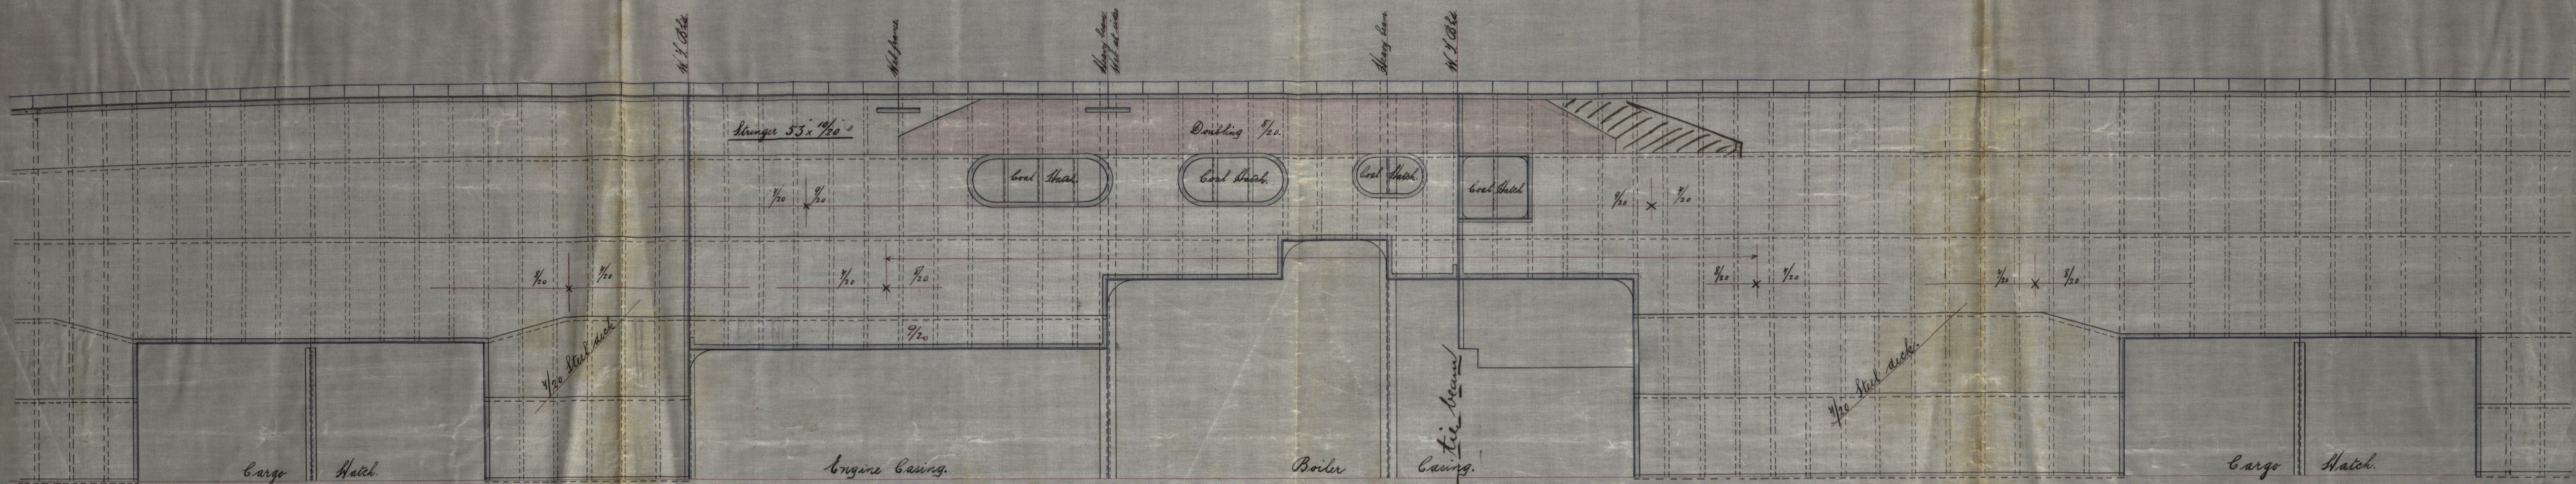


Main Deck.

18/6
17/5/94

Wmston Grange
Deck plating

Rel. Rpt. No 4443

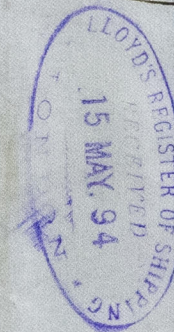

BEL 64-0130



© 2019

Lloyd's Register
Foundation