

9.3.94.  
12.5.94


*S.S. Ulstermore*

MIDSHIP SECTION  
S.S. 450'-0" x 48'-0" x 38'-4" (HEEL TO BEAMS, SPREADS)  
N<sup>o</sup> 288  
TO CLASS 100 AT LLOYDS SPAR D<sup>K</sup> RULE.  
SCALE 1/2" INCH = ONE FOOT



NUMERALS  
51.29 + 24.0 + 31.8 + 58.2 = 165.29 FRAMING N<sup>o</sup>  
107.16 + 448.0 = 555.16 PLATING N<sup>o</sup>  
121.75 + 448.0 + 761 = 1280.75 EQUIPMENT N<sup>o</sup>  
58.998 + 38.336 = 97.334

PROPORTIONS  
9-3 BREADTHS, 10-4 DEPTHS TO MAIN DECK

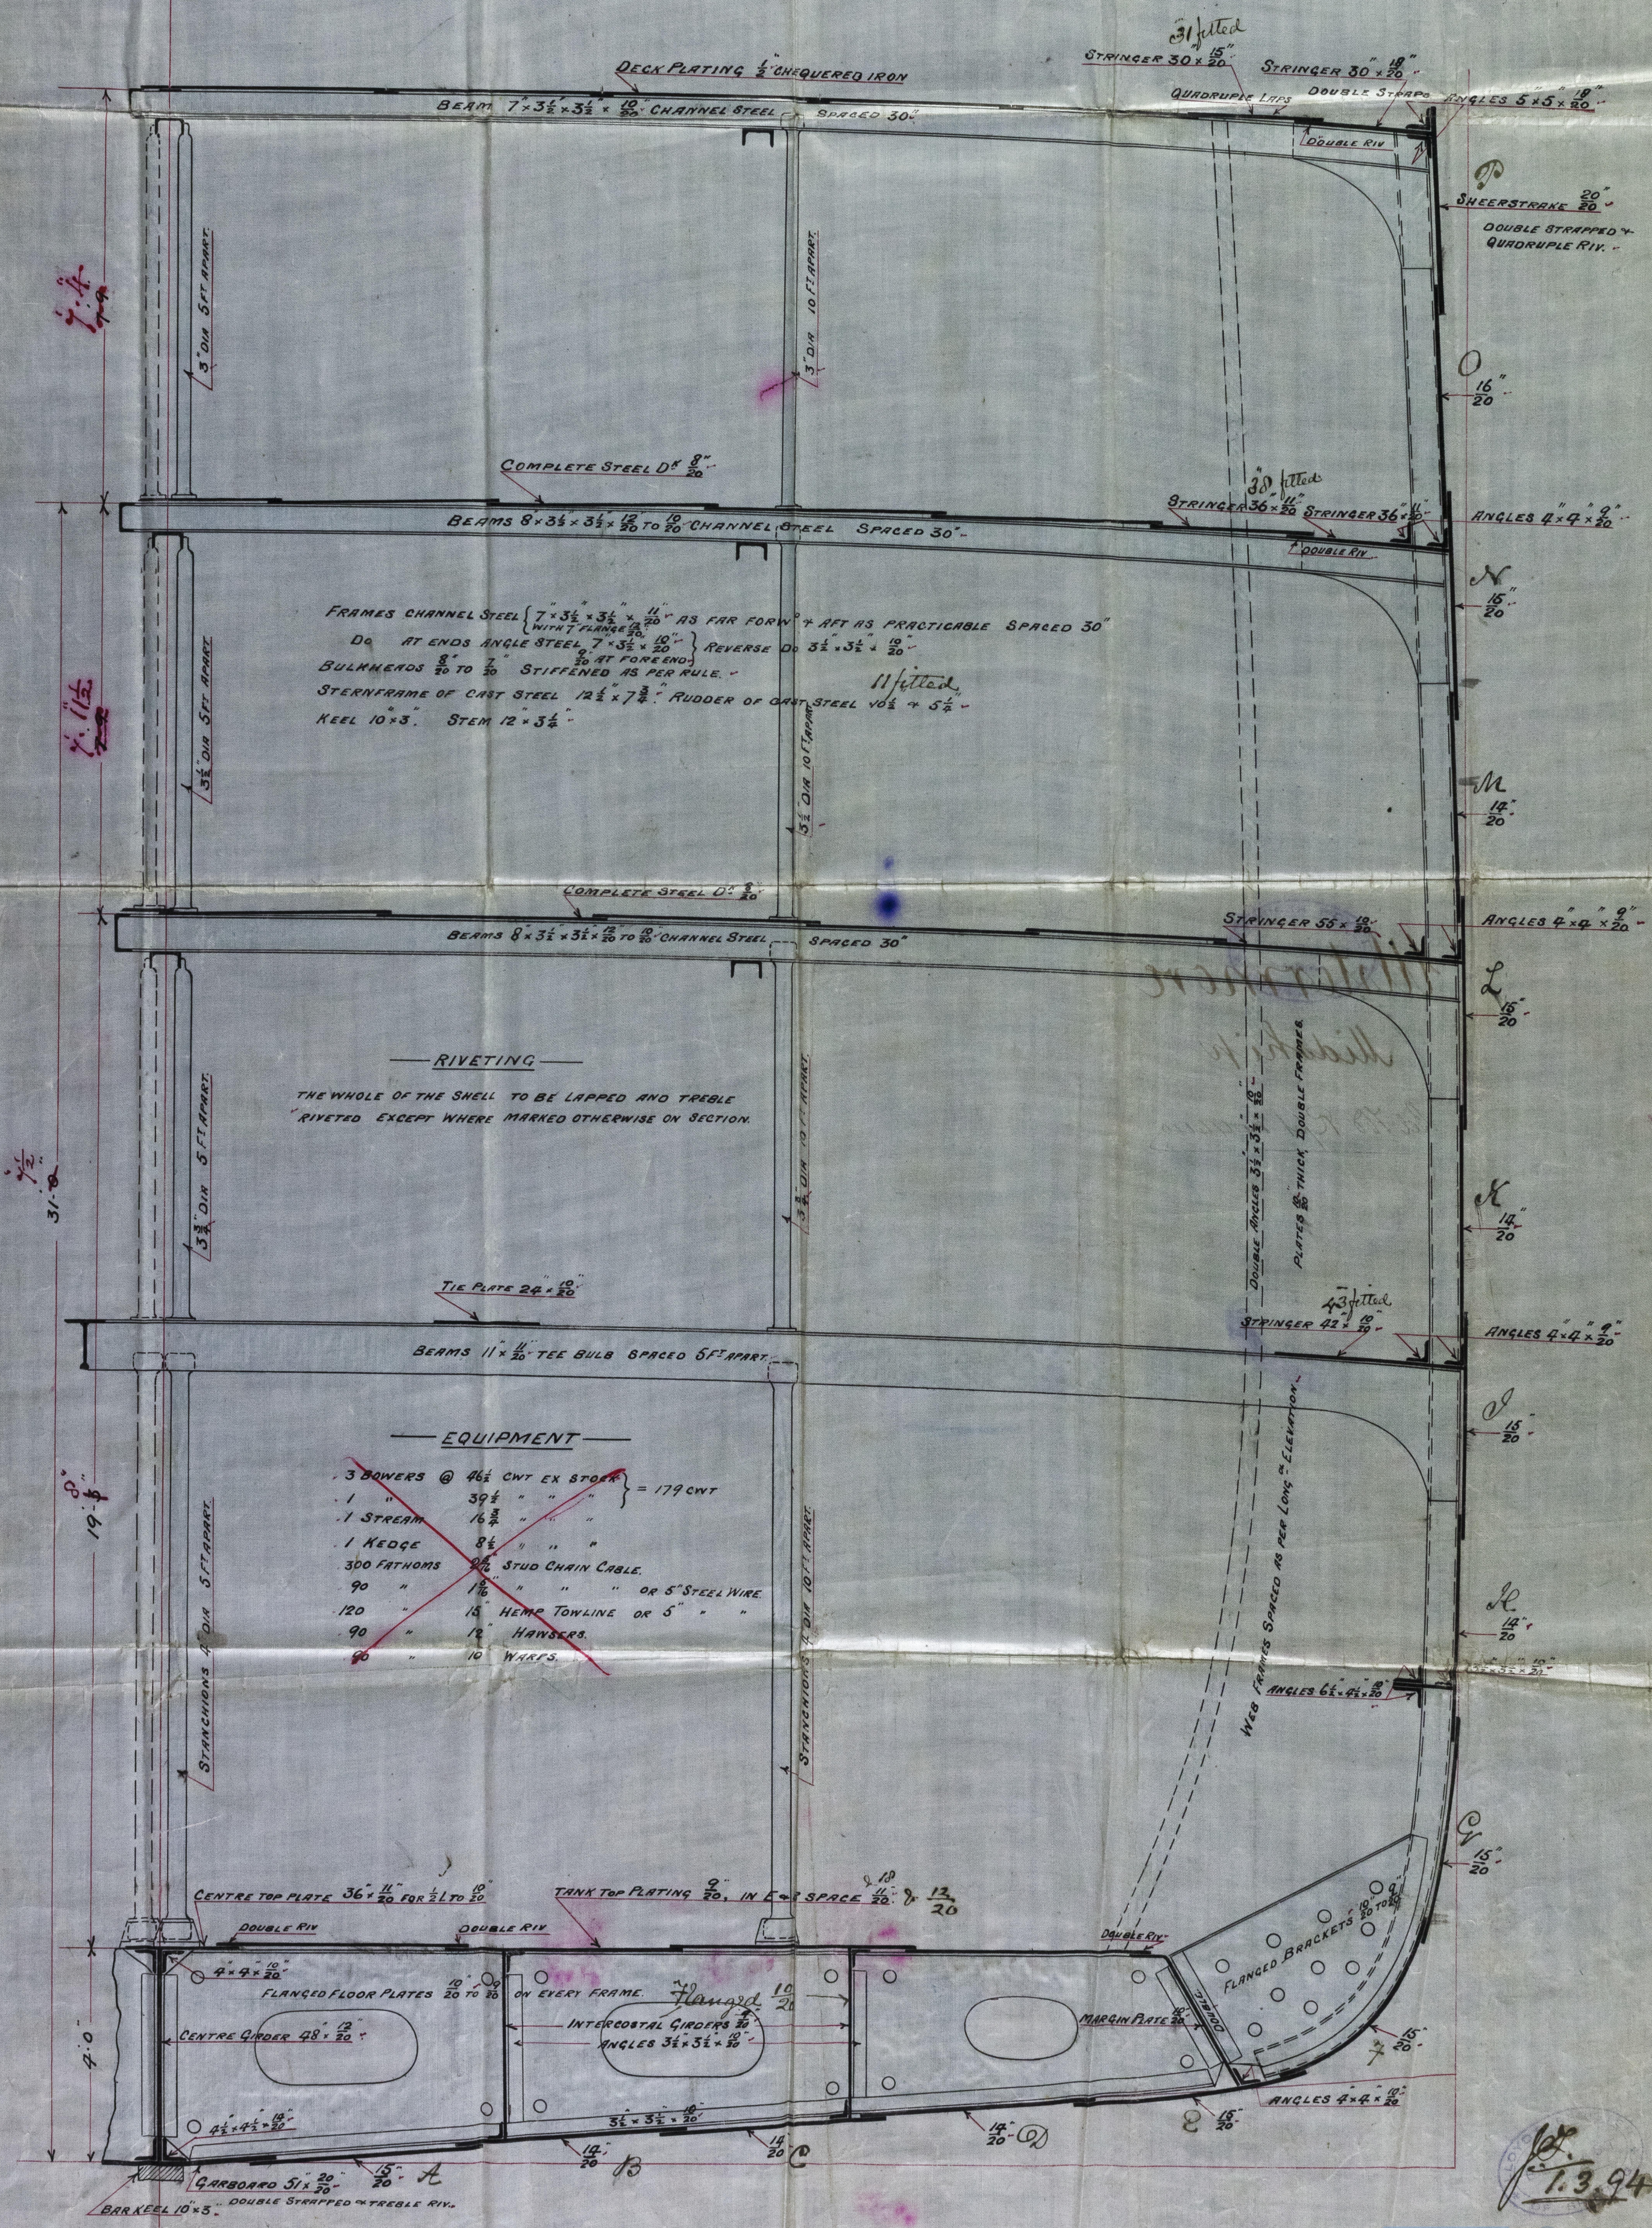

1.3.94



*Ulstermore*

*Midship*

*Bel Hd Rpt no 44410*

© 2019

Lloyd's Register  
Foundation