

- S.S 450'-0" x 48'-0" x 38'-9" TO SPAR D

SCALE $\frac{1}{8}'' = 1 \text{ FOOT}$



1.3.94


27/2/2019

BEL64-0154 Lloyd's Register Foundation

Ulstermore Profile

Bel. H^o Rph No 44440

Bel. Rph. No 44446

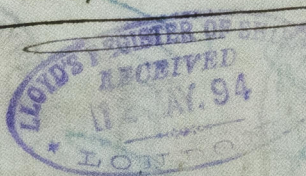

BEL64-0154



© 2019

Lloyd's Register
Foundation