

Received at

Belfast

Office,

Sept

1894

Lloyd's Register of British and Foreign Shipping.

Belfast

(Report on Vessel No. 44446 Port Belfast)

No. 2762.A.

SHIP FORGINGS OR CASTINGS.

I have to report that the undermentioned Iron ~~or Steel~~ Forgings ~~or Castings~~,
 manufactured by The Darlington Forge Co.
 of Darlington for the Vessel No. 288, being built
 by Messrs. Harland & Wolff of Belfast
 have been inspected by me as set forth below, and found to be, so far as can be seen,
sound

Mark on Forgings.

Lloyd's

No. 2762.A

Hugh Cameron


Sundaland

4.9.94

	STERN FRAME.	RUDDER FRAME.	STEM.
Material* ...	/	Scrap iron	/
How made ...		Forged	
Dimensions ...		11"	
Progress on Inspection		Forged & Smithed	
Date when Inspected		from 7th to Aug 31/94	

SKETCHES OF FRAMES SHOWING POSITION AND DESCRIPTION OF WELDS OF FORGINGS, OR PARTICULARS OF TESTS APPLIED TO CASTINGS.

Welds

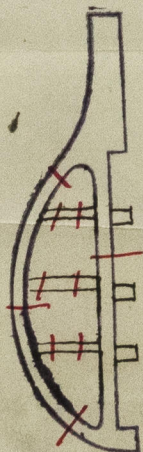

© 2019

Lloyd's Register
Foundation

288

Reader frame

Forging

Ustermore

Rec. Rpt. No 14446



© 2019

Lloyd's Register
Foundation

Handwritten signature or initials.