




G. J. "Cartago Nova."

Sketch of Web Frames proposed to be fitted in place of
Hold Beams proposed to be removed.

76.10.94

Scale 1/2 inch = 1 foot.

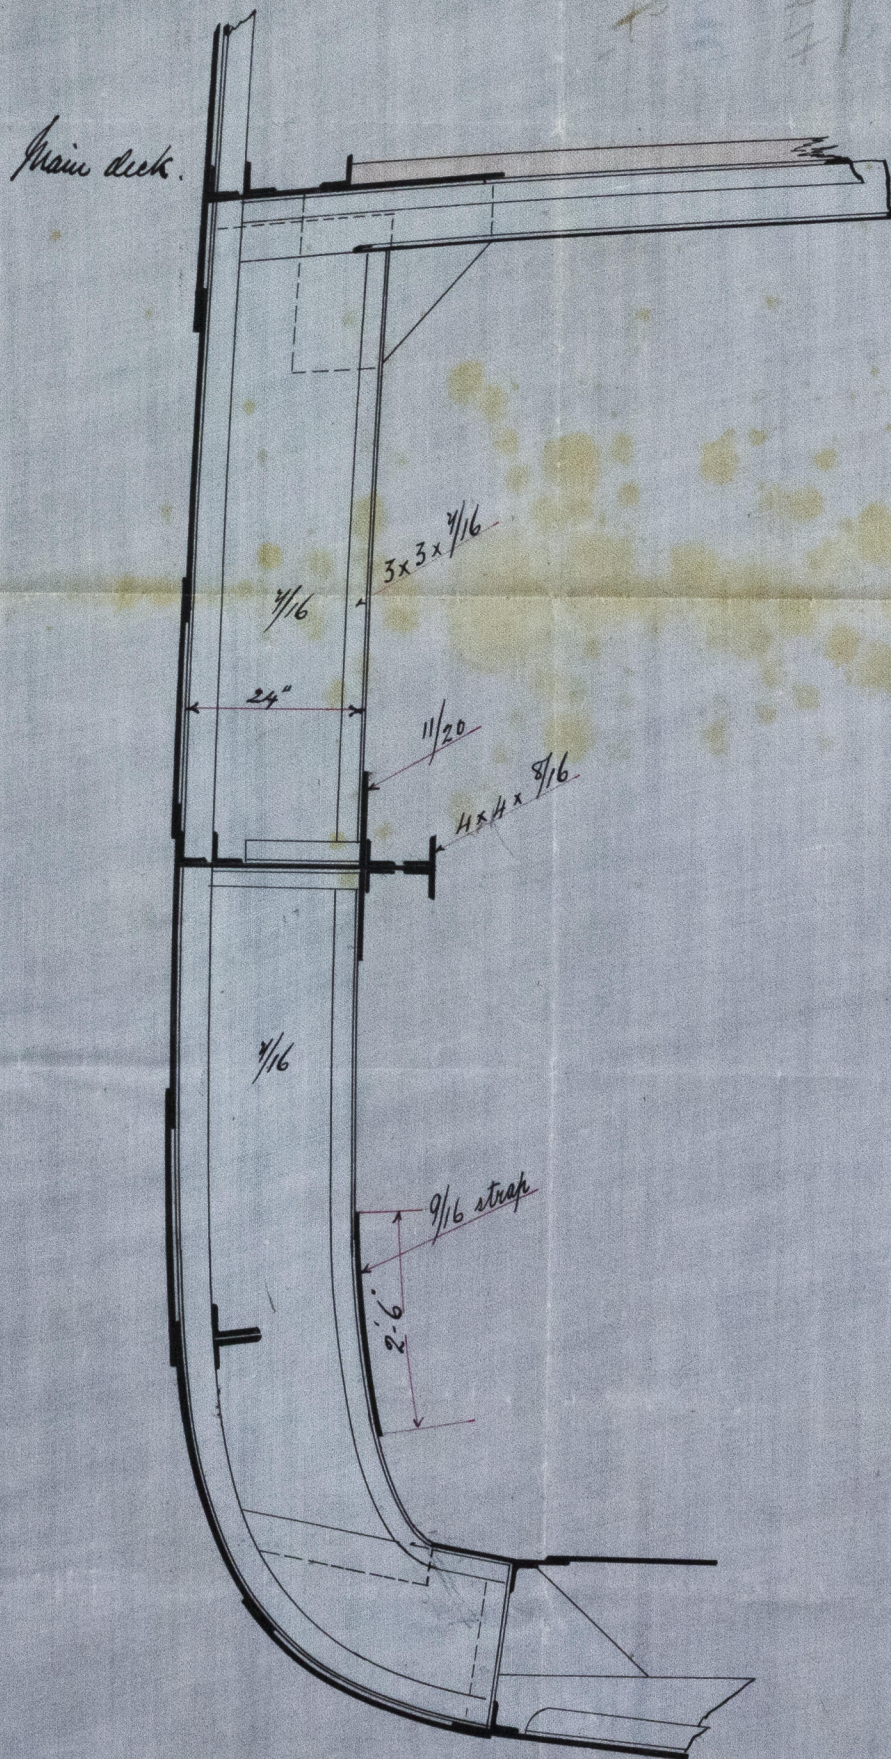

BEL64-0163

李

Rel. Rpt No 4454



Lloyd's Register
Foundation

BEL 64-0163