


Scale $\frac{1}{8}$ inch = 1 foot.

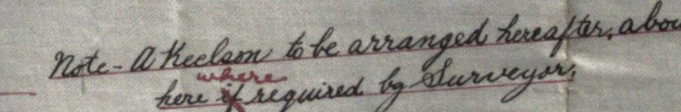

10.8.94
JRB
16/8/94

Lloyd's Register
BEL64-FO196

94
Star of New Zealand

Bel. Libd. Rpt. No 4473

Bel fact first entry Rpt
No 4475

BEL 64-0196

Bel. Libd. Rpt. No 4473

Bel fact first entry Rpt No 4475

© 2019

Lloyd's Register
Foundation

