
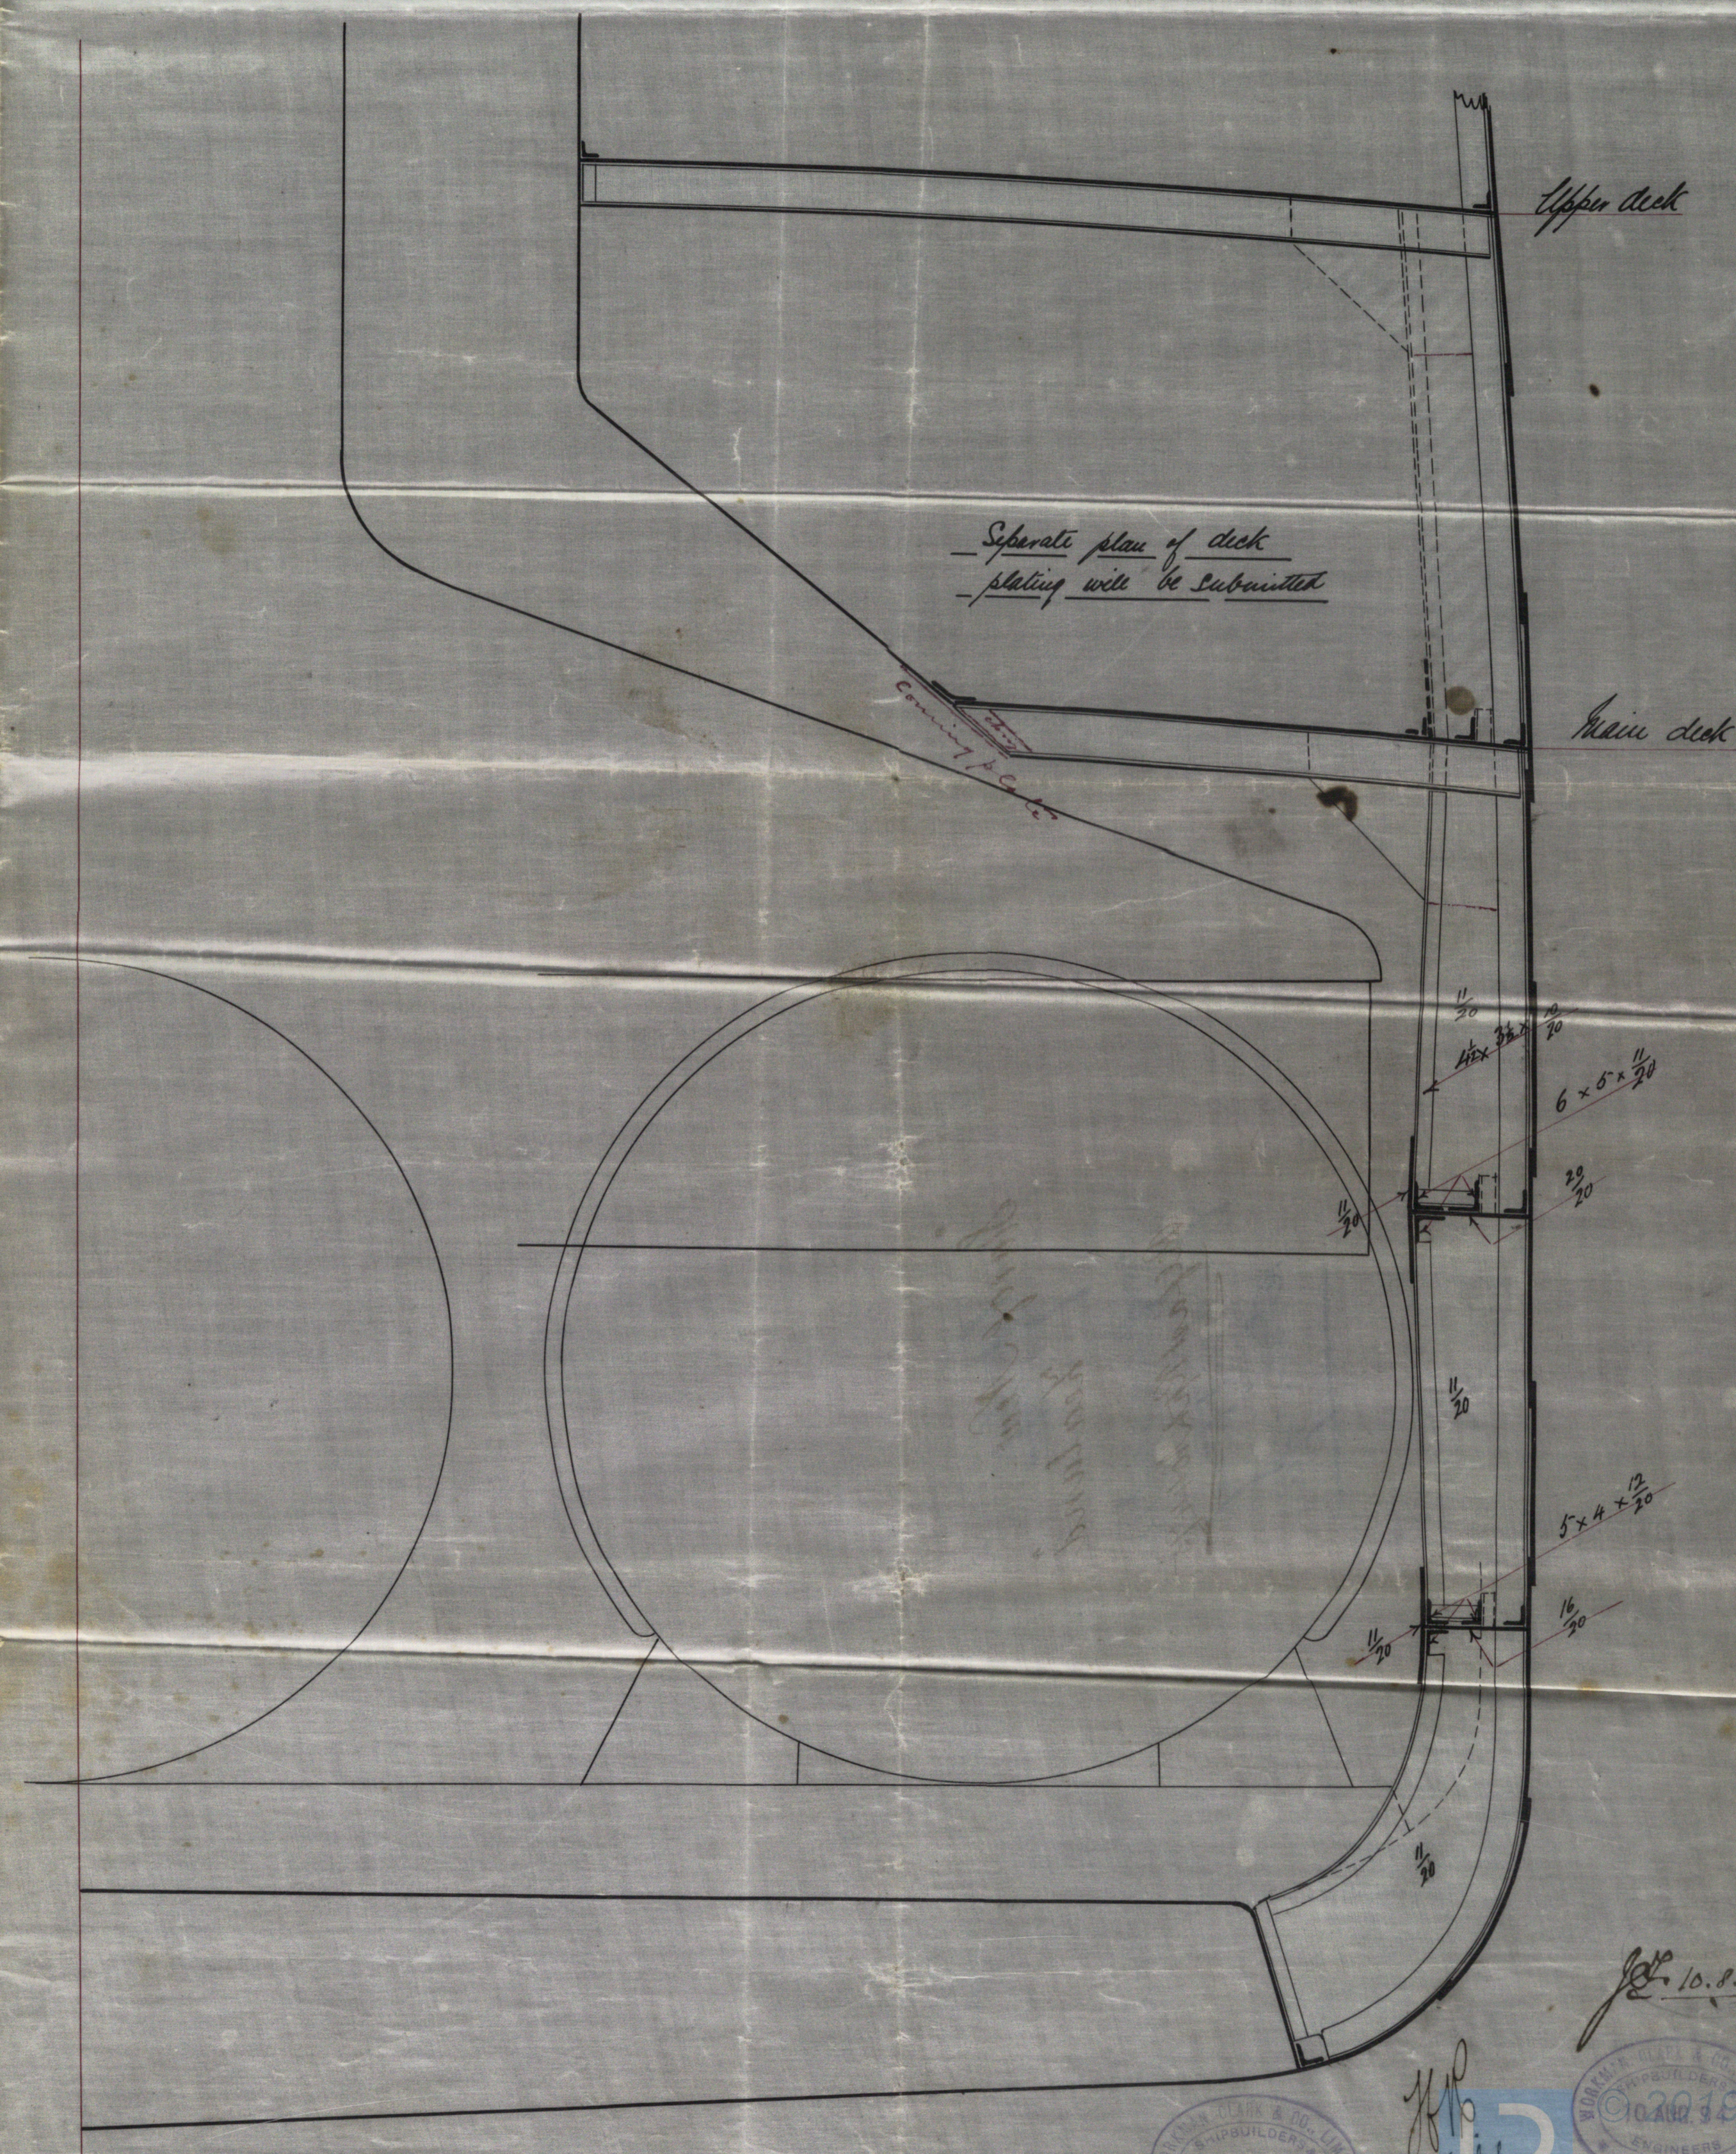


Star of New Zealand

Plan showing compensation proposed for cutting string
abreast of Boilers.

Section at A
Scale $\frac{1}{2}$ inch = 1 foot.

Plan of Stringer.
Scale $\frac{1}{4}$ inch = 1 foot.

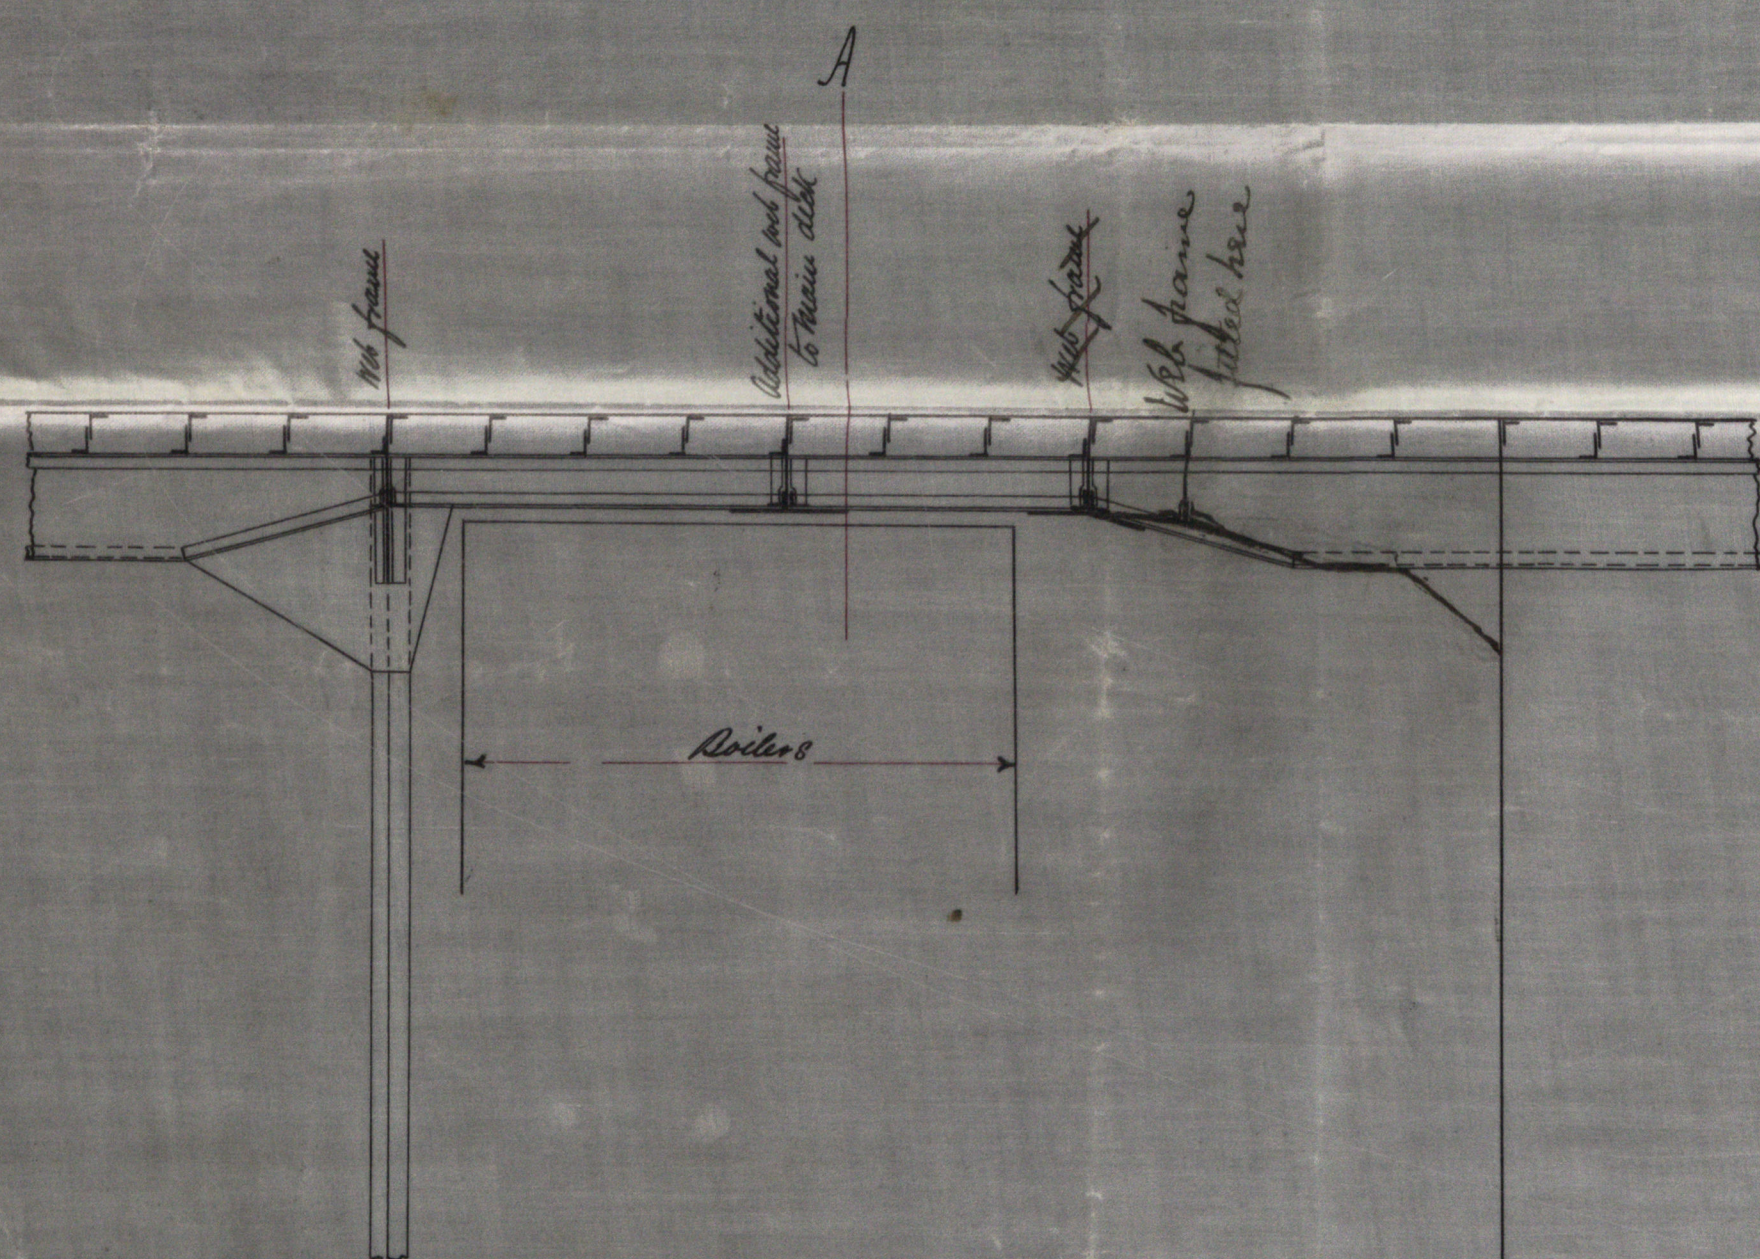

10.8.94



Lloyd's Register
Foundation

BEL 64-019-

Star of New-
Zealand

Belfast Rpt No 4475

stringer

BEL 64-0197



© 2019

Lloyd's Register
Foundation