





No. 8.94

— Arrangement of Midships Beams & Plating 10° 94 S.I. — Plan of New Zealand
— Scale 1/2 inch = 1 foot —

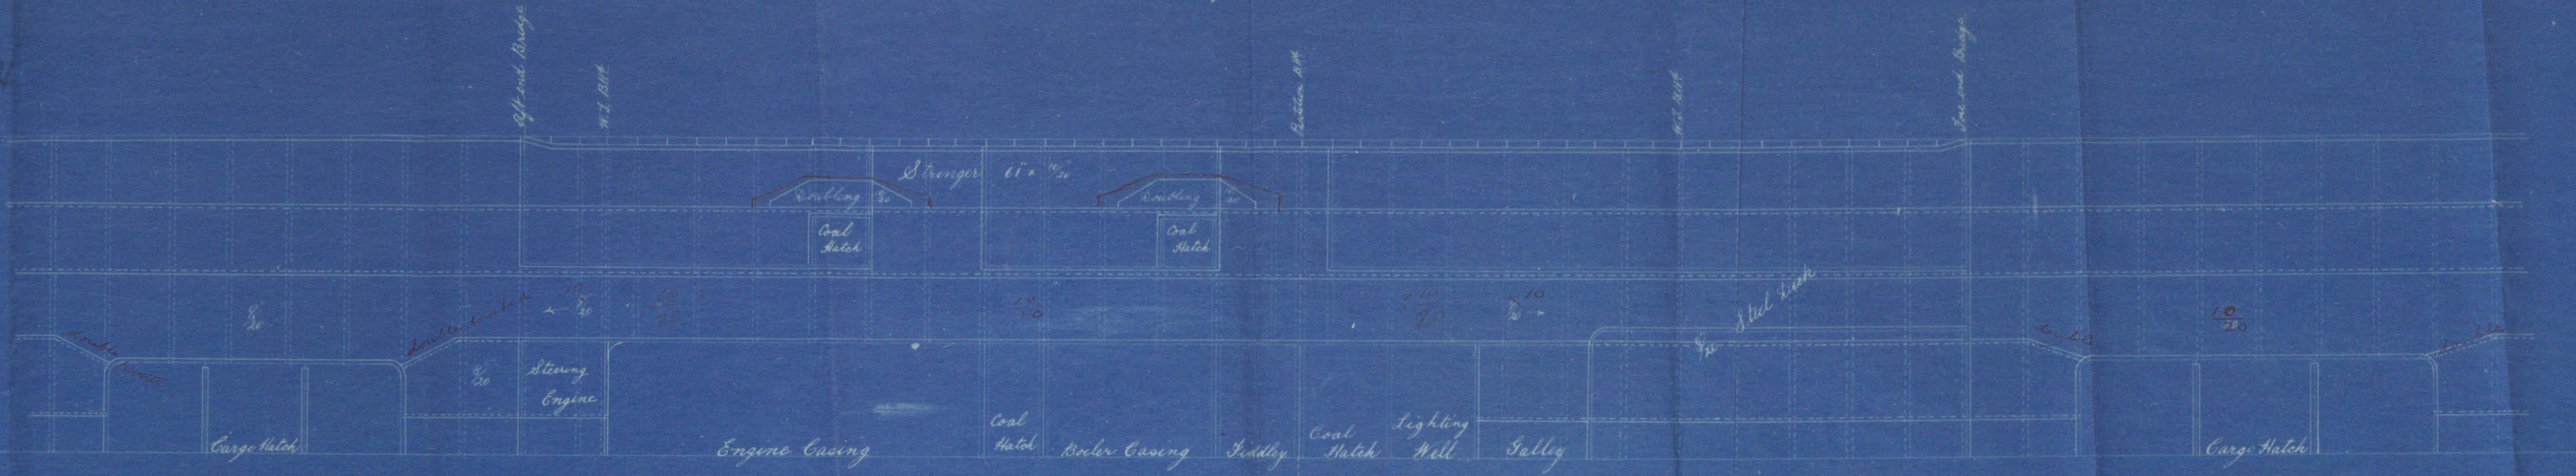

Plan of Upper Deck

Alternative Section on line of
Strong Beam on Bulkhead

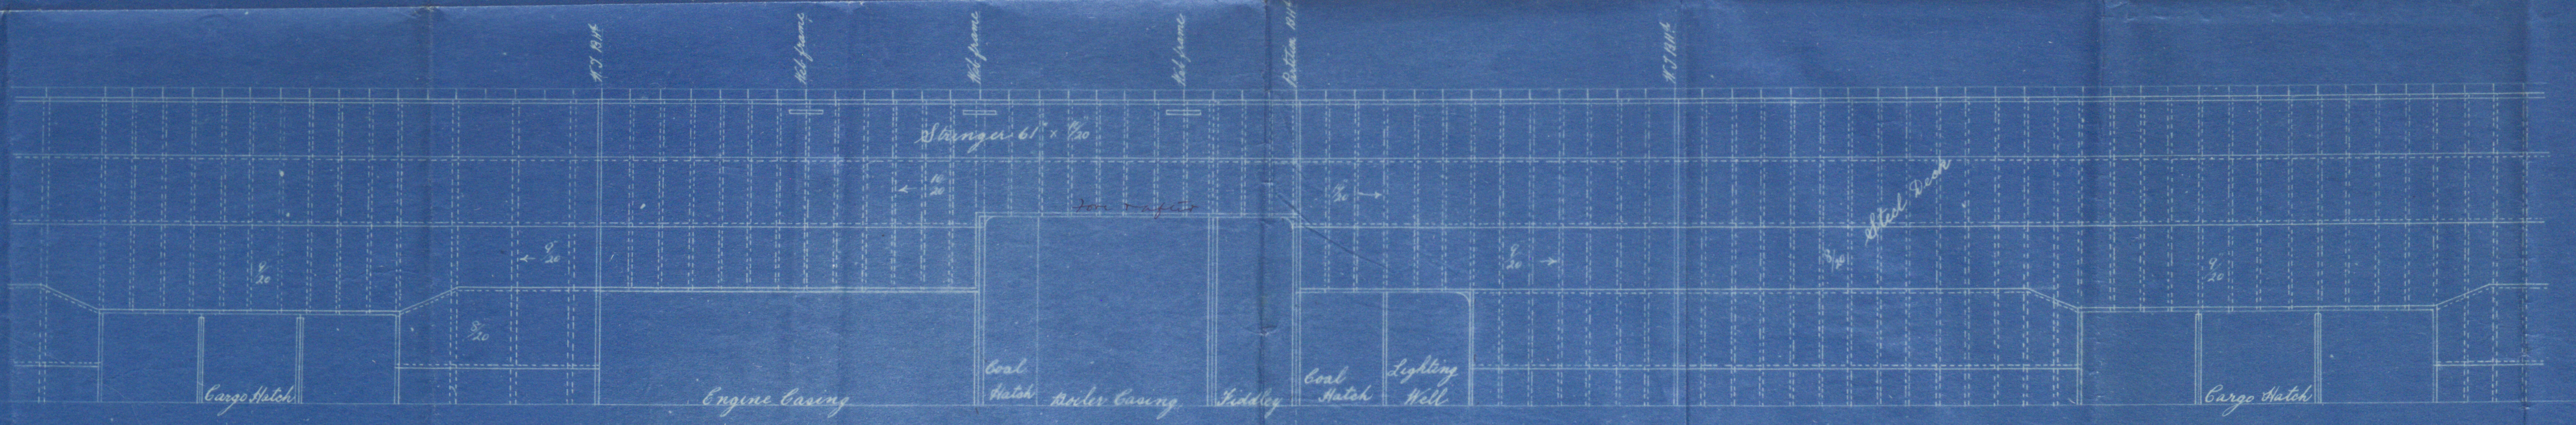

Plan of Main Deck

Alternative Section on line of
Strong Beam on Bulkhead

10 AUG 94
108194



BE66-0210



"Star of New Zealand"

Belfast First Entry Rpt.

No. 447.

Deck Rating



© 2019

Lloyd's Register
Foundation

BEL64-0210