



© 2019

Lloyd's Register
Foundation



Midships Section S.S. "Glenarm"

Shewing increased strengthening in connection with
proposed lengthening of vessel by 14 frame spaces

Scale $\frac{1}{2}$ inch = One foot.

9.1.95
14.3.95

Numerals to put additional length.

53.20 framing no.

203.53

10827.8 2nd no

848.

977

11705.8 ~~11804.8~~ ~~framing no.~~

Proportions

Breadth. 7.4

Depth. 14.2


Length of section 132 feet

No Doubling for $\frac{1}{2}$ in

Plank $9 \times \frac{1}{2}$ for $\frac{3}{5}$ length
Angles $4 \times 3 \times \frac{1}{2}$ for $\frac{3}{5}$ length

Intercentals
fitted for $\frac{1}{2}$ inch

18M
9/11/95

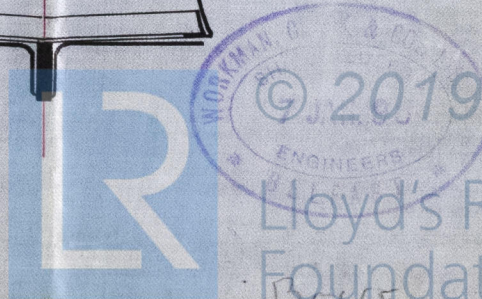

Lloyd's Register
Foundation

13666-011