


— Longitudinal Elevation of H<sup>o</sup> 120 S.S. — 4 No. 122

— Scale 1/8" = 1 foot. —

appd. 27.12.94


no. 123 appd. 28.3.95

19. 11. 94  
22. 12. 94  
4. 2. 95  
9. 7. 95

 

J.H.  
19/11/94

15.11.94

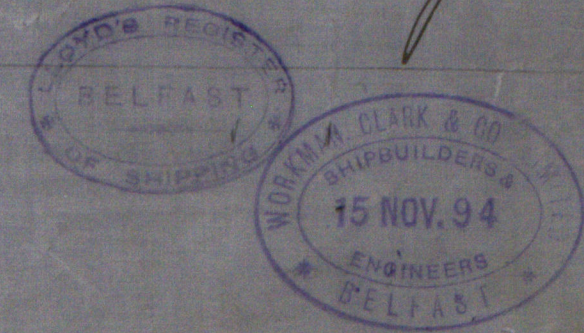



S. S. Pakling

Report

No 4536

Profile

LLOYD'S REGISTER OF SHIPPING  
RECEIVED  
13 APR. 95  
LONDON

LLOYD'S REGISTER OF SHIPPING  
RECEIVED  
13 APR. 95  
LONDON

LLOYD'S REGISTER OF SHIPPING  
RECEIVED  
20 DEC. 94  
LONDON

LLOYD'S REGISTER OF SHIPPING  
RECEIVED  
27 MAR. 95  
LONDON

LLOYD'S REGISTER OF SHIPPING  
RECEIVED  
27 DEC. 94  
LONDON

LLOYD'S REGISTER OF SHIPPING  
RECEIVED  
27 DEC. 94  
LONDON

120

Profile

LLOYD'S REGISTER OF SHIPPING  
RECEIVED  
10 NOV. 94  
LONDON

LLOYD'S REGISTER OF SHIPPING  
RECEIVED  
10 NOV. 94  
LONDON

2 copies of plan & section  
to be sent to the  
Lloyd's Register of Shipping



© 2019

Lloyd's Register  
Foundation