

S. S. "Pakling" (No 120)

Midship Section of No 120 S.S. 4 No. 122 appd: 27.12.94

— To Class 100 A1 — 3 Decks Steel. —

No. 123 appd. 28.3.95

Scale $\frac{1}{2}$ = 1 foot

19. 11. 94

22. 12. 94

4. 2. '95

14:8:95 9.7.95

Bridge Deck



Section of frame

Shell plating entirely in way of double bottom
excluding girders to be reduced $\frac{1}{20}$ where $\frac{1}{20}$ & above
The scantlings of floors & increased $\frac{1}{20}$ under boilers space
and all other parts of
double bottom

J.H.L.
19/11/94
27/12/94

ALLOYD'S REGISTER
LONDON
15.11.94
OF SHIPPING



© 2019

Lloyd's Register
Foundation



*"S.S.
Takling"*

Midland

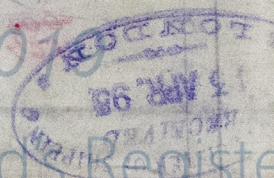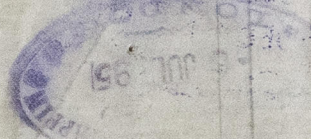

© 2015
Lloyd's Register
Foundation