



15.2.95

Midship Arrangement of Beams & Deck Plating No 114 S.S. —
Scale $\frac{1}{4}" = \text{one foot.}$

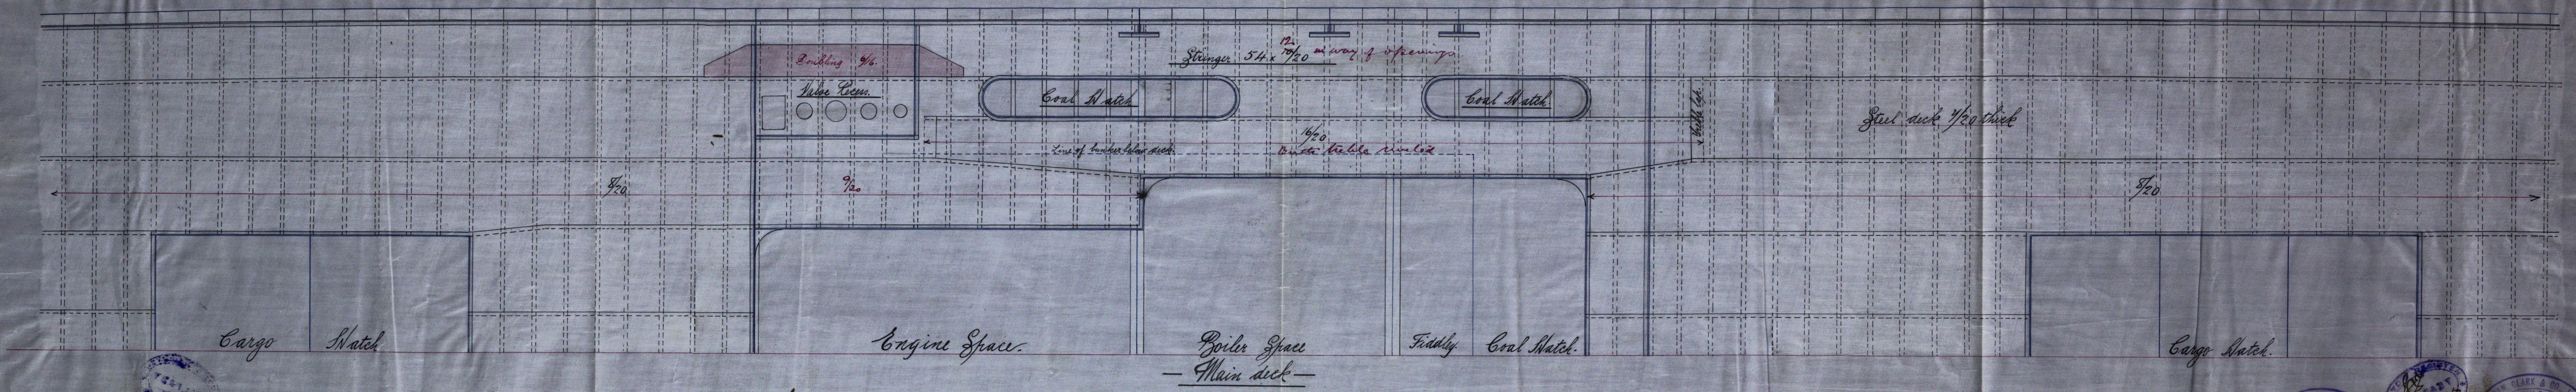

J.V.L.
15/2/95~

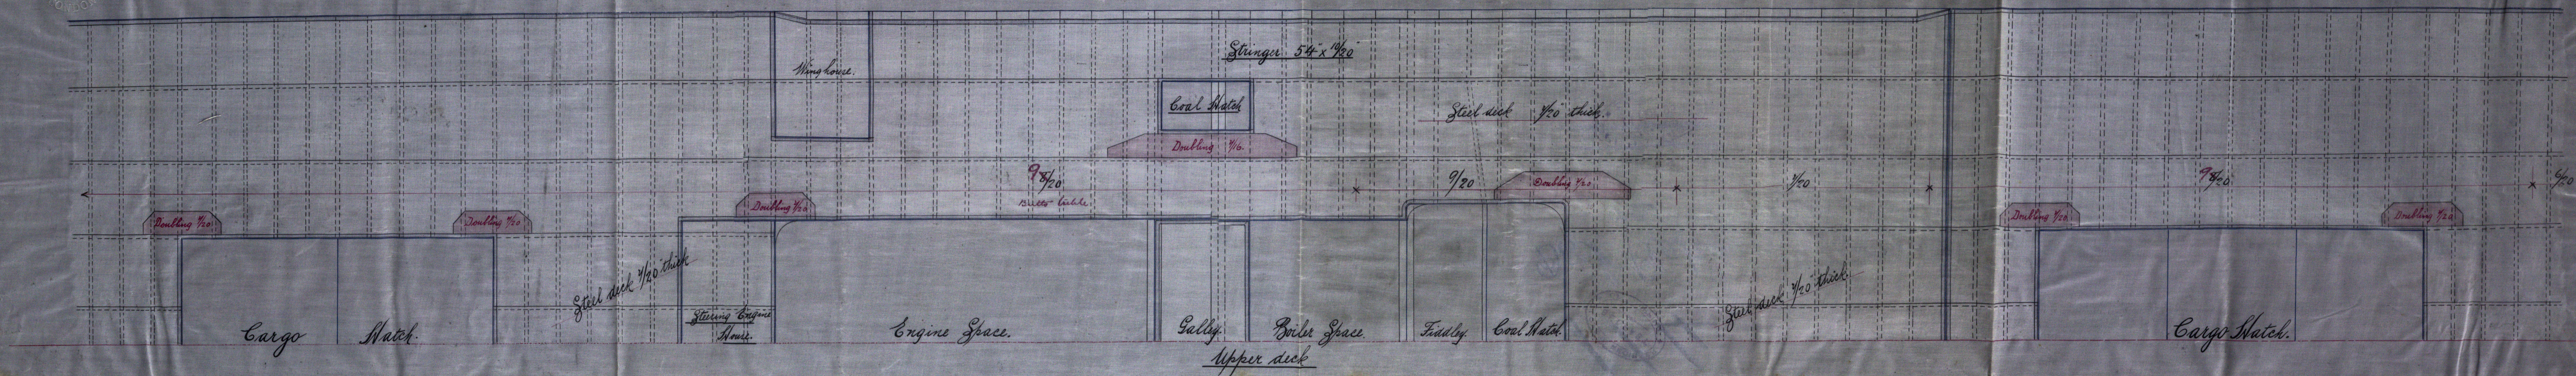


13295

W. & A. CLARK & CO., LTD.
SHIPBUILDERS &
11 FEB. 95
ENGINEERS
BELFAST



Deck Plating
etc

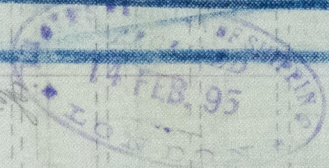

Belfast Registry No 145874

"
" *Mourne* ^{5/8}



© 2019
Lloyd's Register
Foundation