


LLOYD'S REGISTER OF  
 LONDON  

Pumping Arrangement No 114 S. S.  
 Scale 1/4 inch = 1 foot.  
 1/80

J. M. M.  
 11/11/95

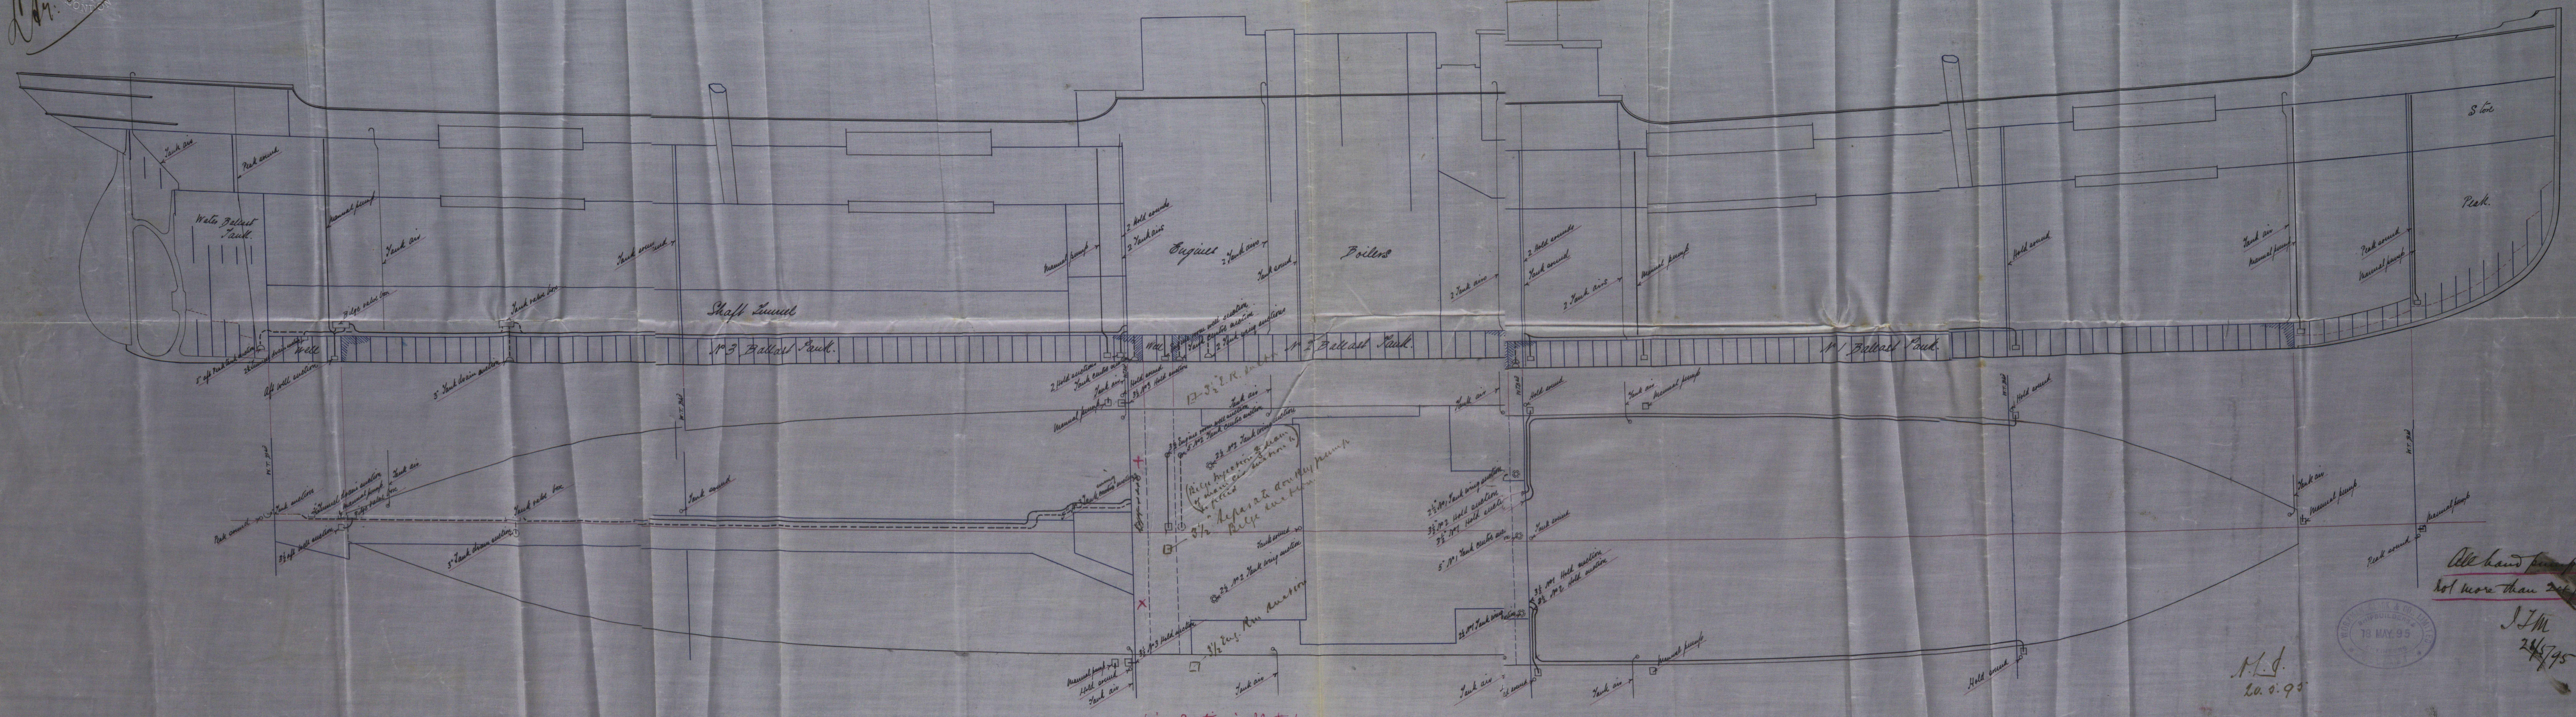

Bring Suctions in No 3 tank

All hand pumps to have  
 not more than 24\"/>

M. J.  
 20. 5. 95





J. M. M.  
 24/7/95

BELGS-165



1/2 "Mourne"

Belfast. Rph. No 4534

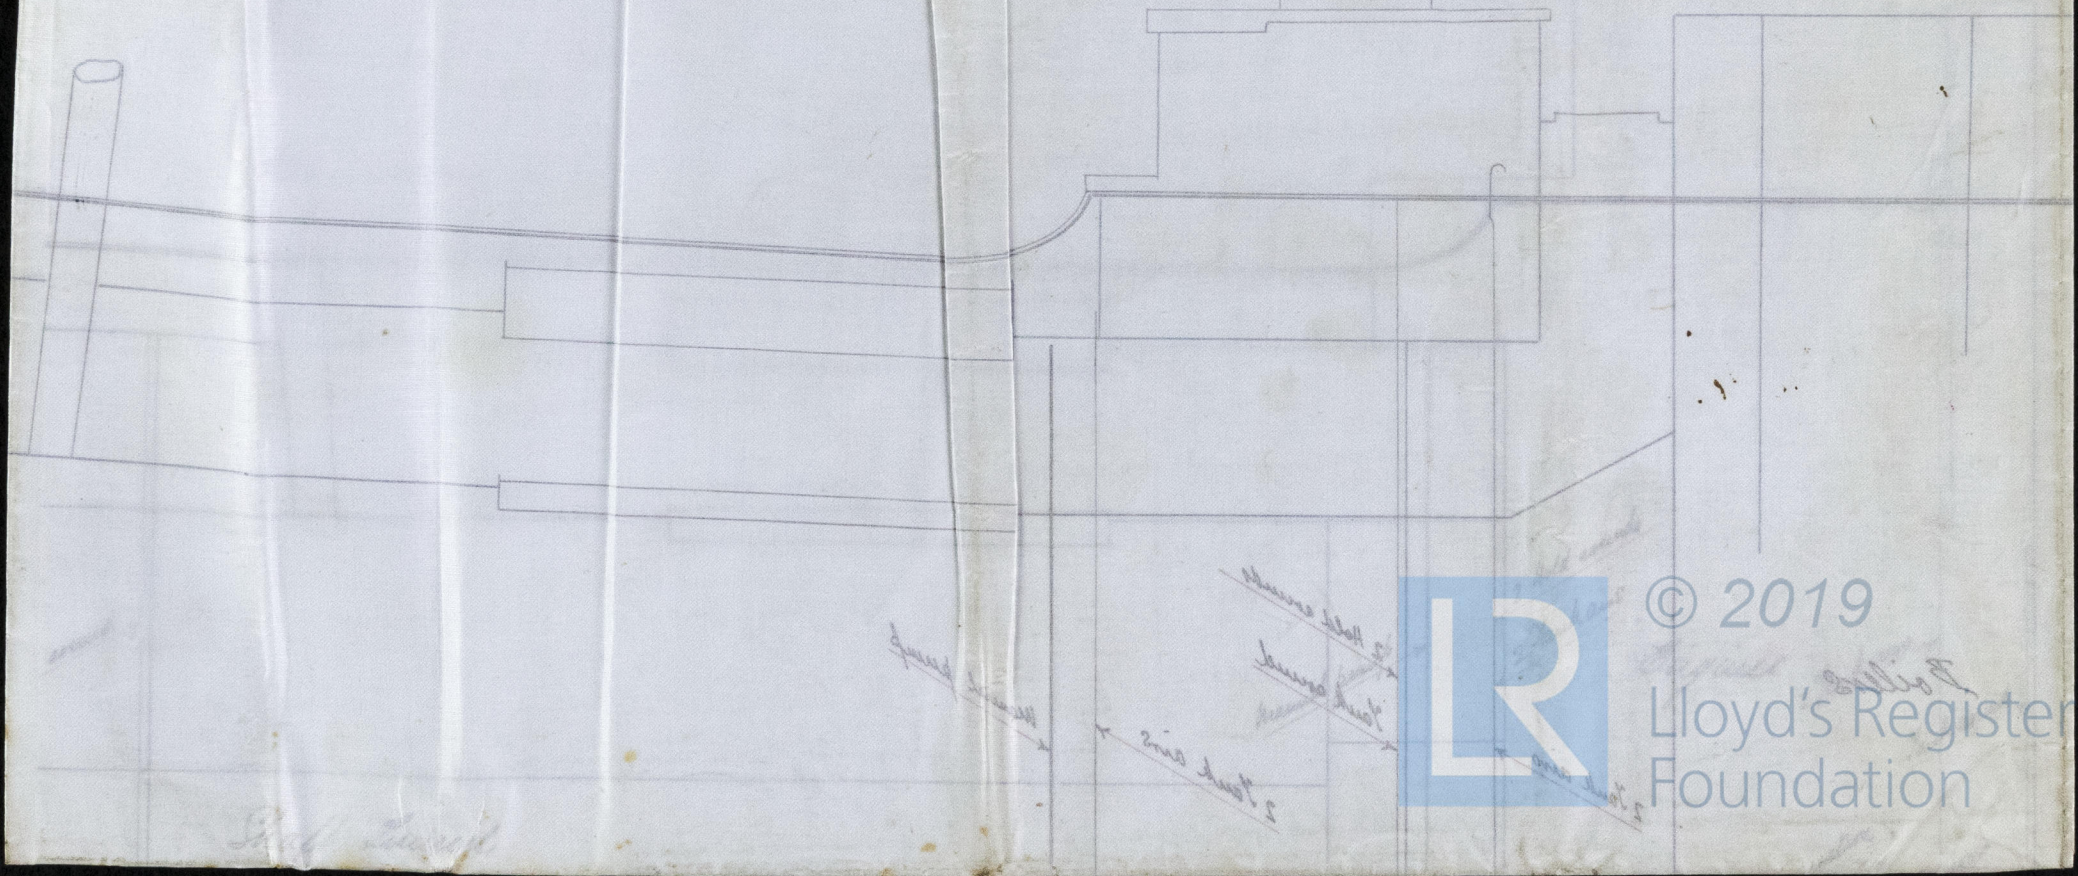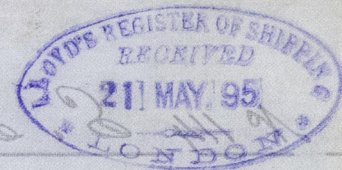

© 2019  
Lloyd's Register  
Foundation