


27.12.94

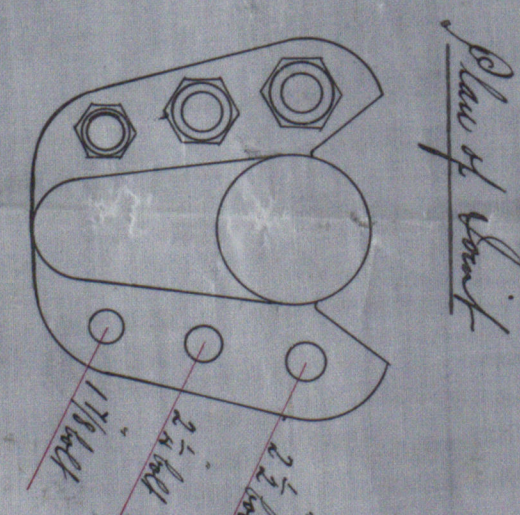


Stern & Rudder Frames No. 114 S.S.

Scale 1 inch = 1 foot



Front of Rudder Post

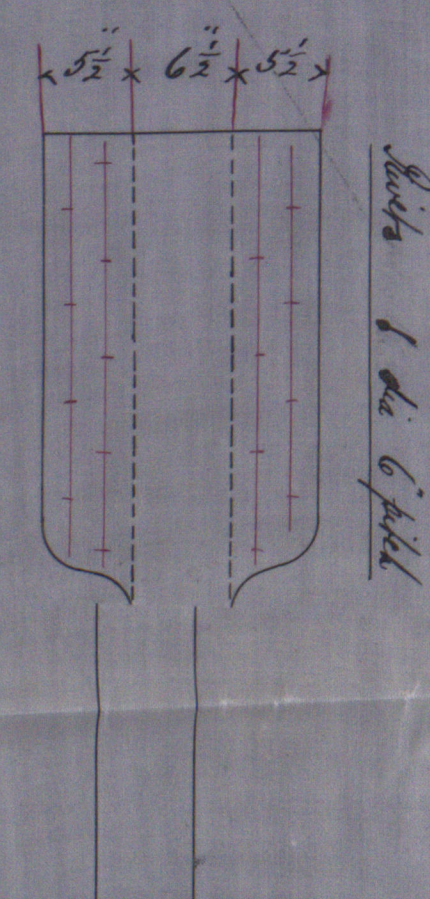

Revised  
27.12.94

Plate 2 1/2" thick  
All rivets 1 1/2" dia.

Half Section of Rudder


Plan of Rudder Post





St. Mourne  
Belfast Report No 455+



*Handwritten notes:*  
Hampden  
Hampden  
Hampden

*Handwritten note:* Plan of Deck

*Handwritten note:* 4 ft 2 in over 100 ft



© 2019

Lloyd's Register  
Foundation