


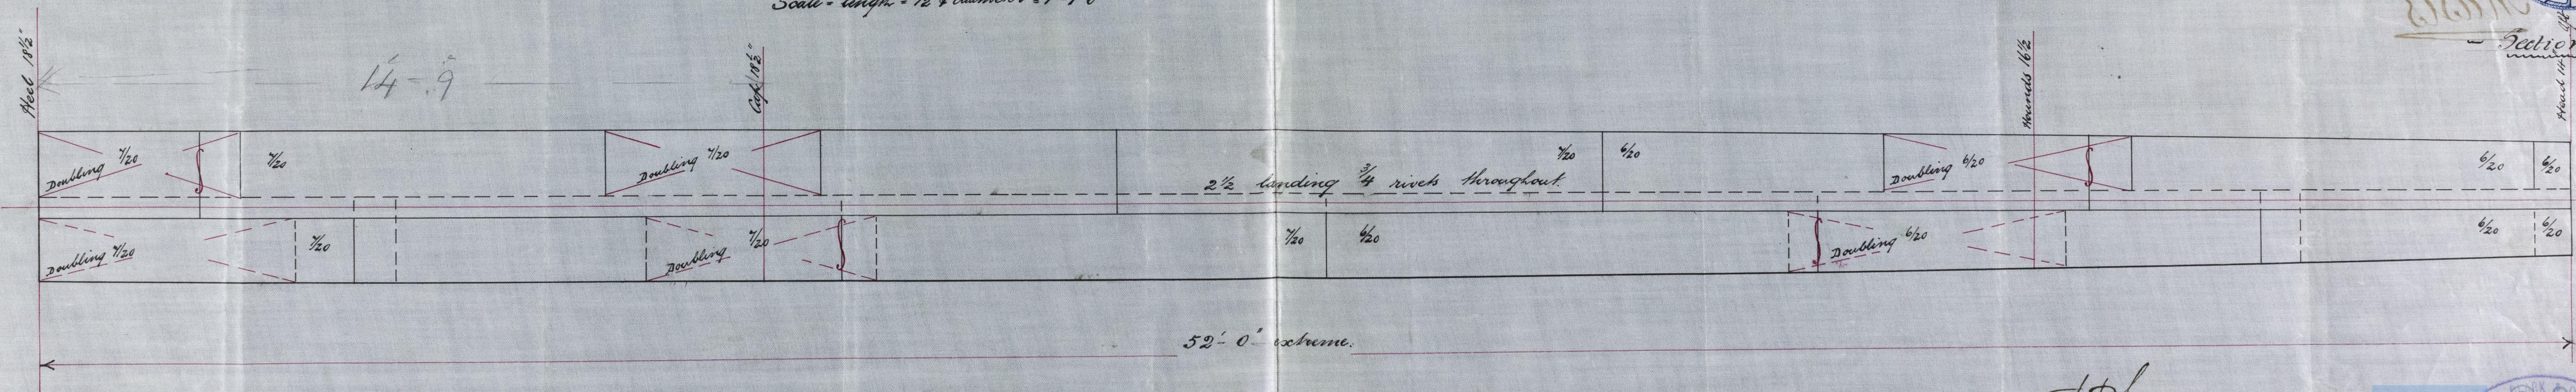
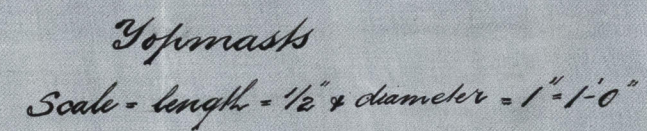


Lower Topsail Yards
Scale $\frac{1}{2}" = 1'-0"$

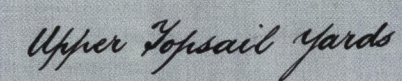

J.D.
20/11/95

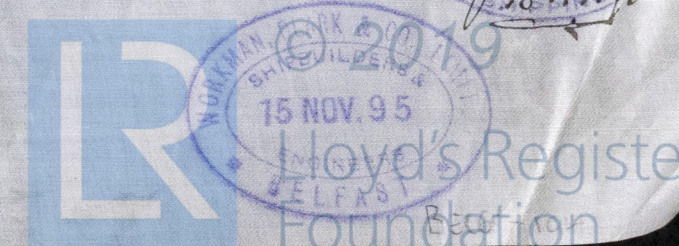

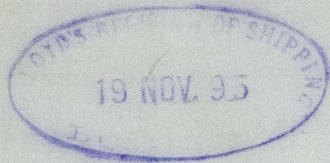

Masts

19 NOV 95

1925/26

05/05 2005

add print

9.4.12

© 2019

Lloyd's Register
Foundation