


17. 1. 95
31. 1. 95
7. 2. 95
20. 2. 96

No 297 S. S. Fran

SCALE $\frac{1}{2}$ INCH = ONE FOOT.

26.0 + 35.33 + 56.12 + 5 - 7.0 = 110.95 = FRAMING N^o ✓
 110.95 x 450.0 - - - - - = 49922.5 = PLATING N^o ✓
 117.70 x 450 + 2366 - - - = 55,545 = EQUIPMENT N^o ✓

8.6 BREADTHS. 12.7 DEPTHS TO UPPER D^N 16.4 DEPTHS TO MIDDLE D^N LOWEST POINT
12.6 — " — " — " — 16.3 — " — " — " — MIDDLE OF LENGTH

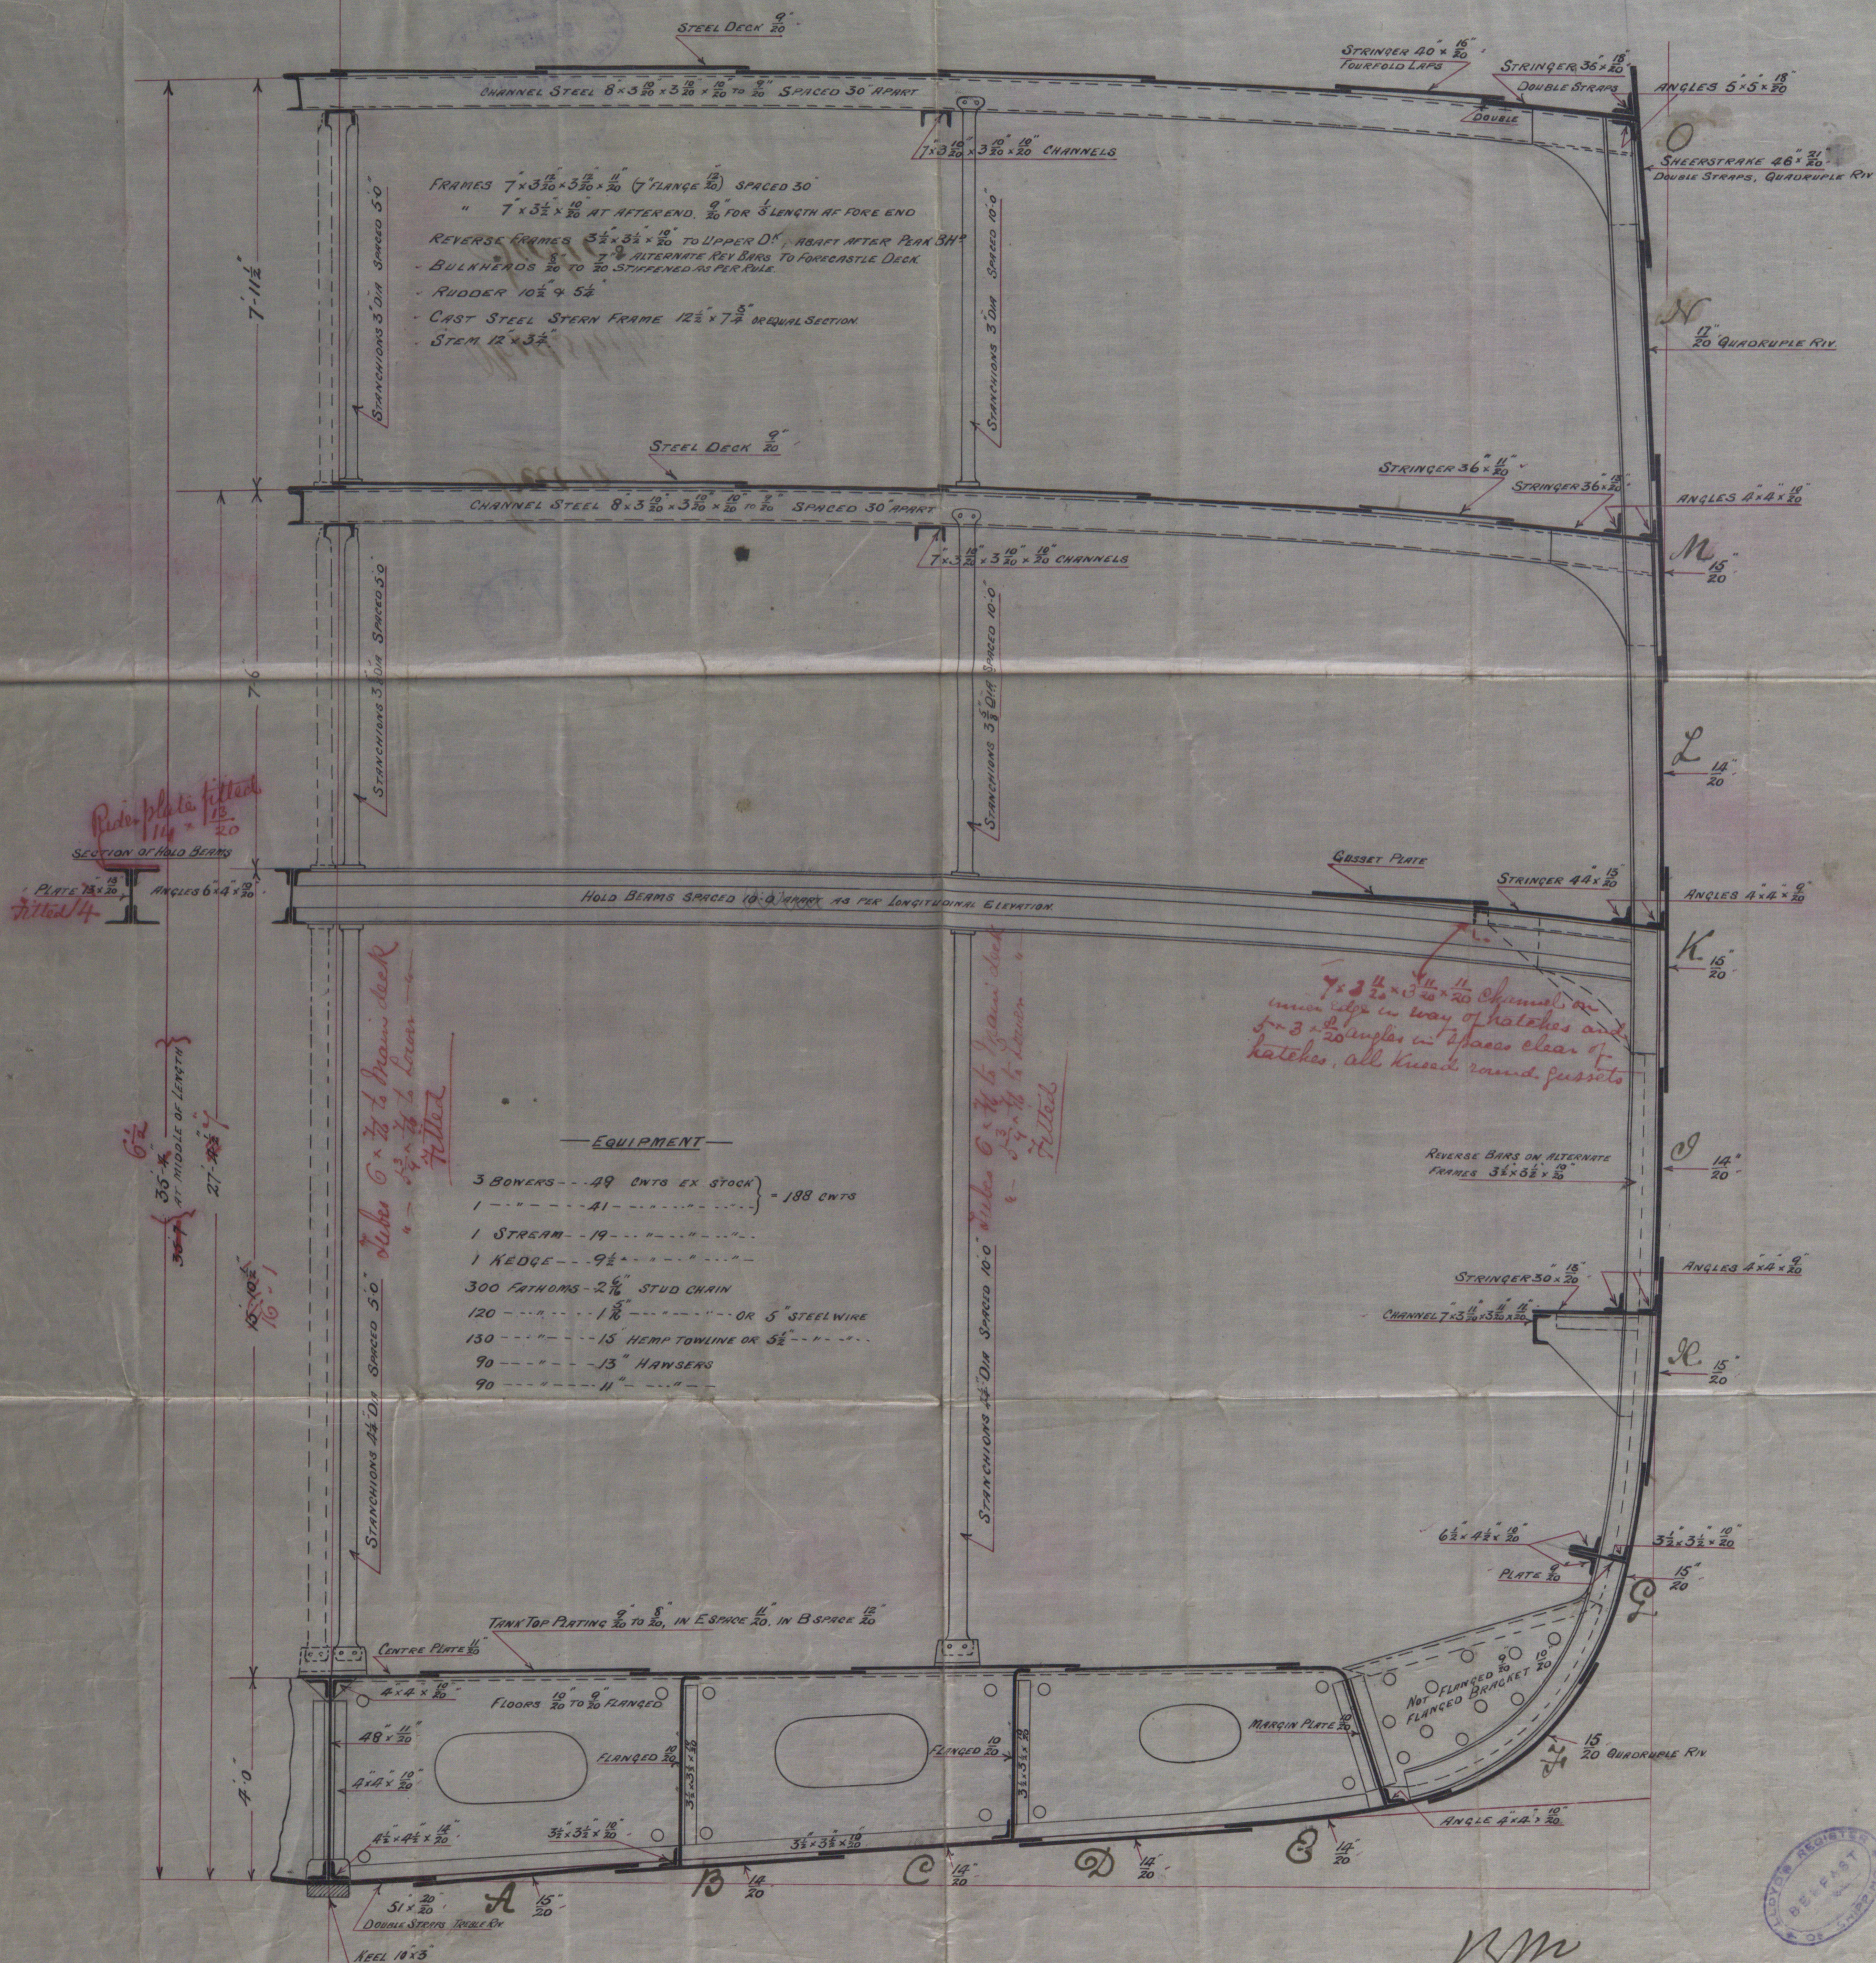

13m
17/1/95

24/1/95

297

Iran

Midship

Section

BEL66-0122



© 2019

Lloyd's Register
Foundation