


6:00
LLOYD'S REGISTER OF SHIPPING
70:
LONDON
Rm:



— N° 297 —
— PUMPING PLAN —
— Scale $\frac{1}{8}'' = \text{ONE FOOT}$ —

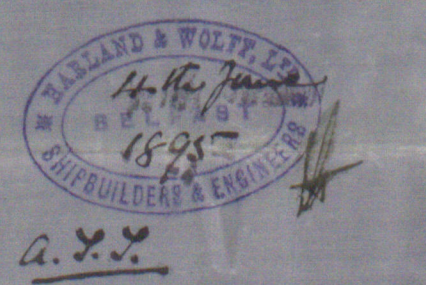

Large timber hole
in gutters

M.L.B.
6.6.95

Jim
8/6/95

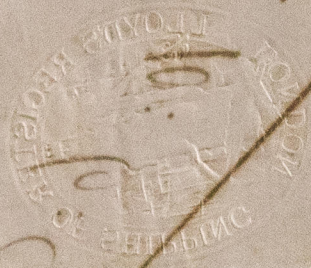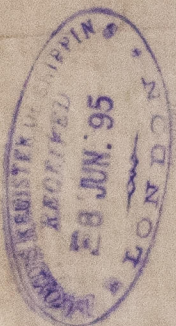

BEL66-0128

294
"Iran." Belfast Report.
No. 4606

