

Lloyd's Register of British and Foreign Shipping.

(Report on Vessel No. _____ Port _____)

No. 1092.

SHIP FORGINGS OR CASTINGS.

I have to report that the undermentioned Iron or Steel Forgings or Castings, manufactured by *Messrs. Clay, Inman & Co.* of *Birkenhead Forge* for the Vessel No. 124, being built by *Messrs. Workman & Clark* of *Belfast* have been inspected by me as set forth below, and found to be, so far as can be seen, *sound and free from defects*

Mark on Forgings.

Lloyd's


No. 1048
P.M.G.

J.M. Grogan.

Liverpool

	STERN FRAME.	RUDDER FRAME.	STEM.
Material*	Scrap Iron		
How made	Forged		
Dimensions	12" x 4 3/4"		
Progress on Inspection	Forging & completed		
Date when Inspected	Various dates from May 4 th to July 17 th 98		

SKETCHES OF FRAMES SHOWING POSITION AND DESCRIPTION OF WELDS OF FORGINGS, OR PARTICULARS OF TESTS APPLIED TO CASTINGS.

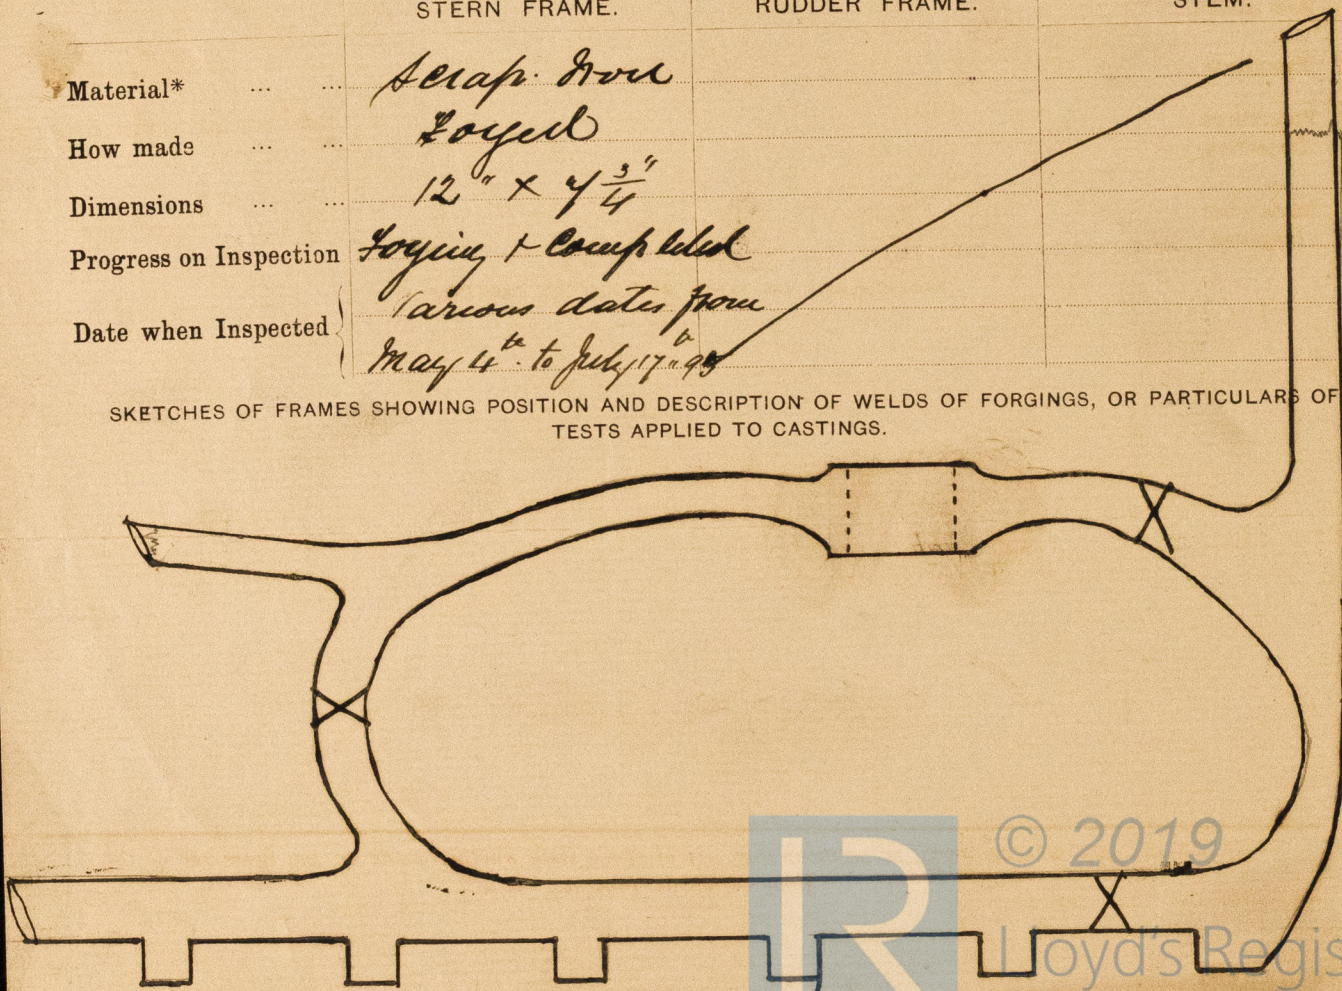

* If of Iron, state whether scrap or puddled Iron.


BFL66-0154

124

Stem frame forgy

194 Langton Grange

Belfast Report No. 4619

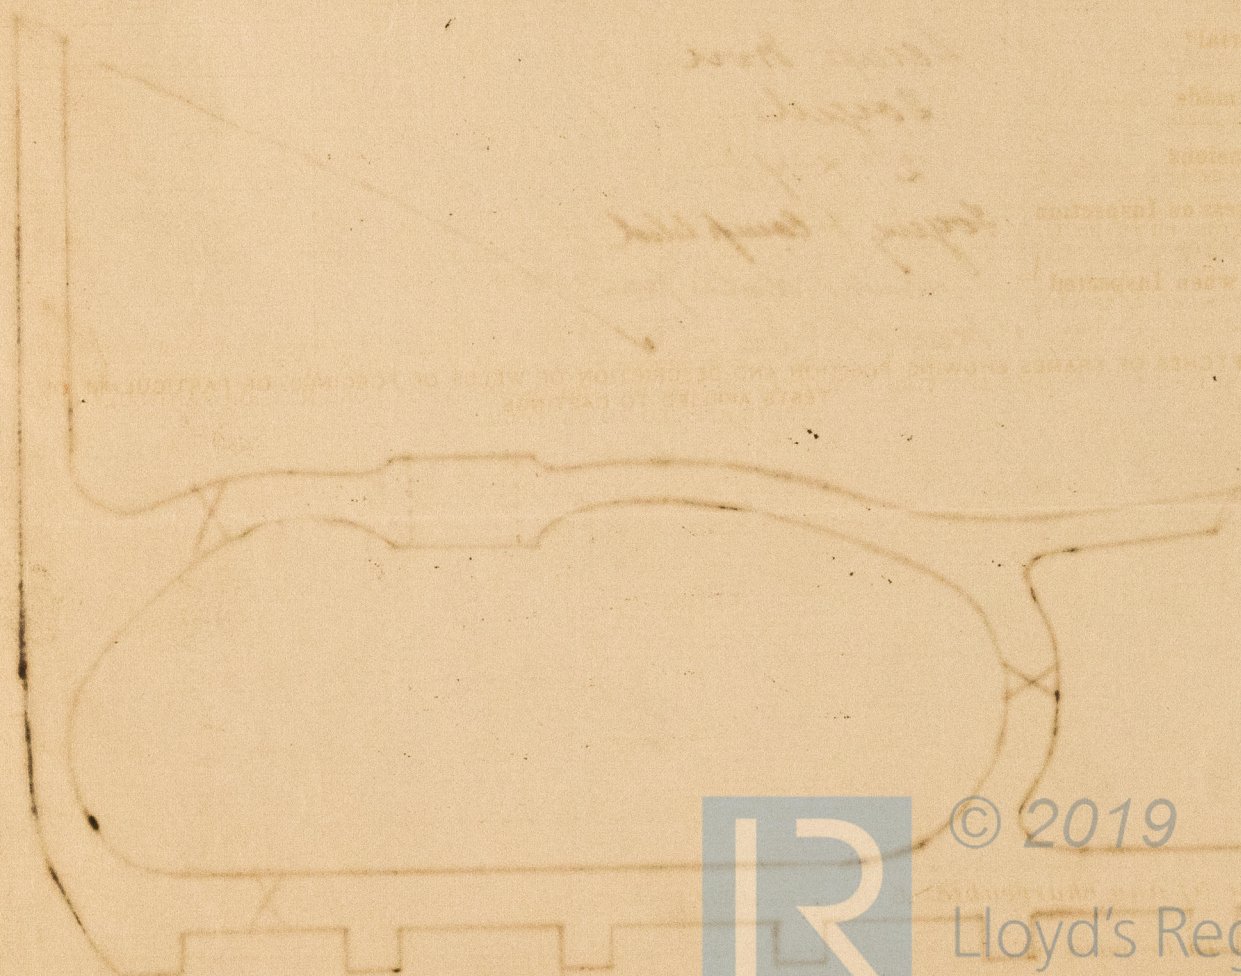

© 2019

Lloyd's Register
Foundation