


Scale $\frac{1}{8}$ inch = 1 foot.

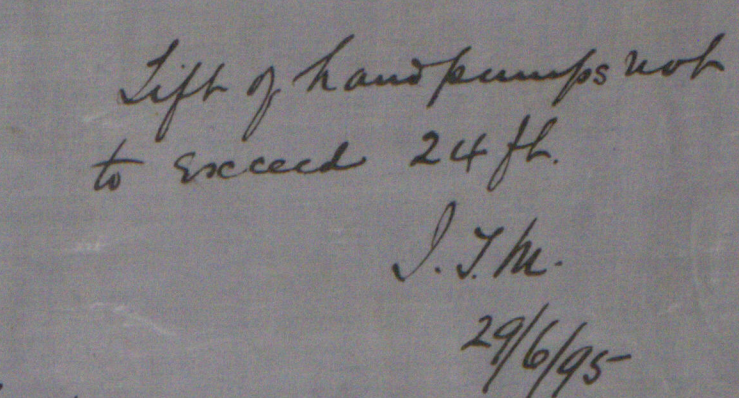

Belfast Report No.

Lloyd's Register
Foundation

