



— N^{os} 124 & 125 S. S. —

Proposed Arrangement of portable Stanchions in insulated holds —


— Scale 1 inch = 1 foot. —

8-8-95

Vertical
Stanchion

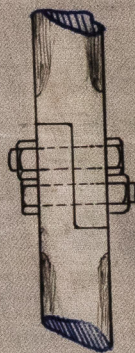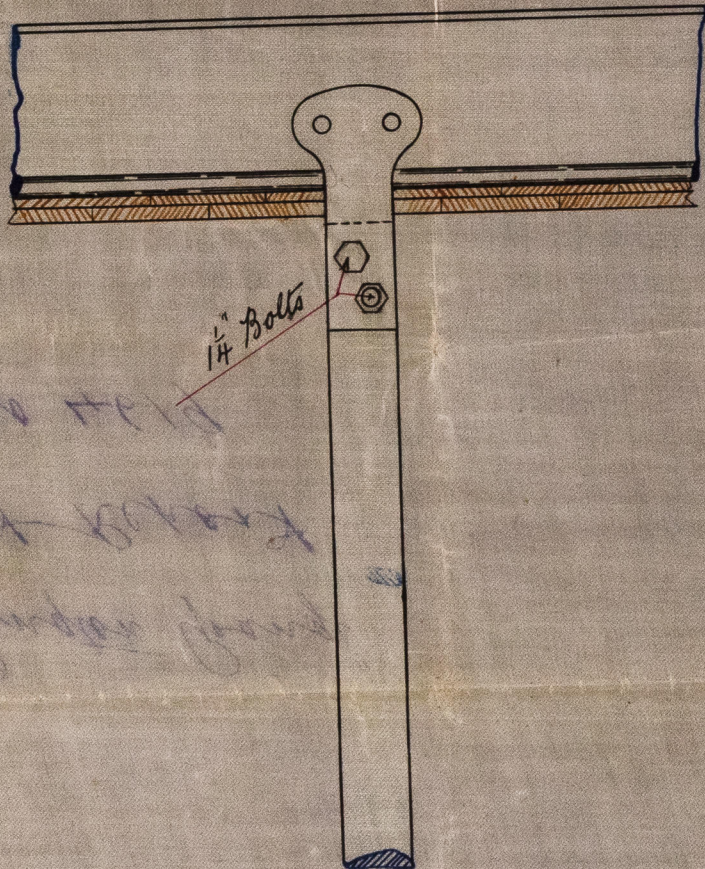

— Side view of joints. —

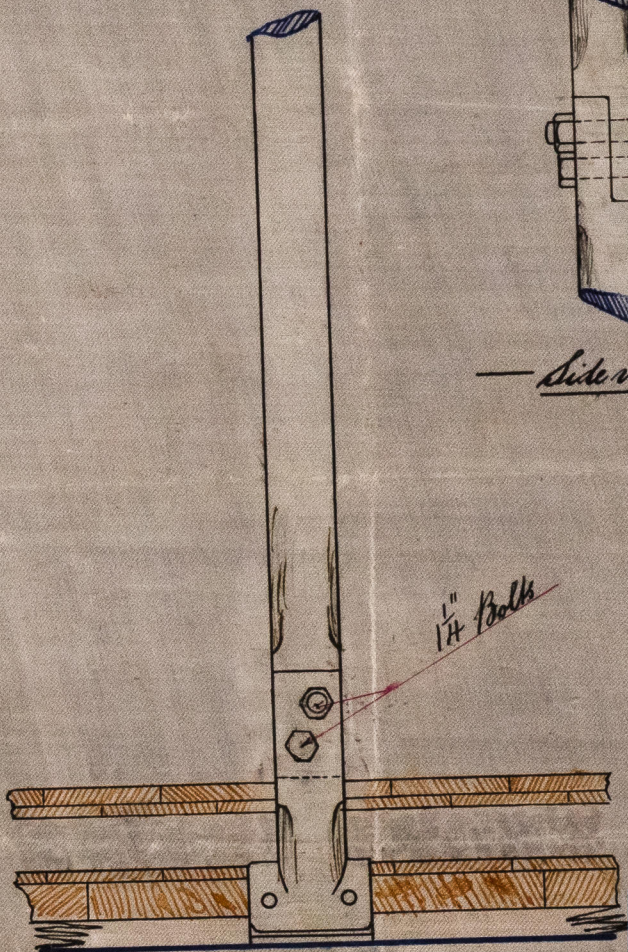

A.L.D.
6th Aug 1895




019

Lloyd's Register
Foundation

J.H.L.
8/8/95

Bel. Rep
 Kirkman Clark & Co
 No 124
 Kingston House
 Portsea
 Stanchions

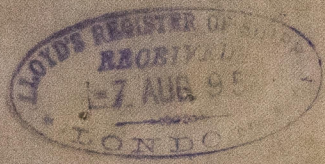


194 "Langston House"
 Belfast Rivers

No 4619

8.2.02

BEL66-0218

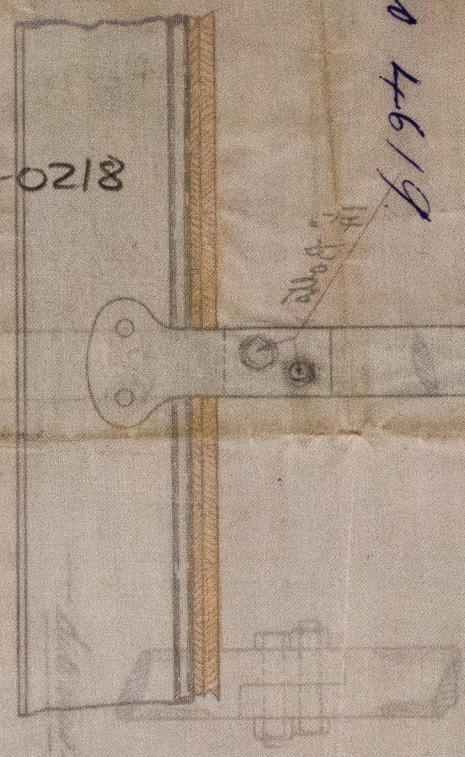






© 2019
 Lloyd's Register
 Foundation