




10.6.95

Brackets for Side Stringers Nos 124 & 125 S.S.
Scale 1 1/2" = one foot

10.6.95
10.6.95
10.6.95

Nos 1 & 4 Stringers

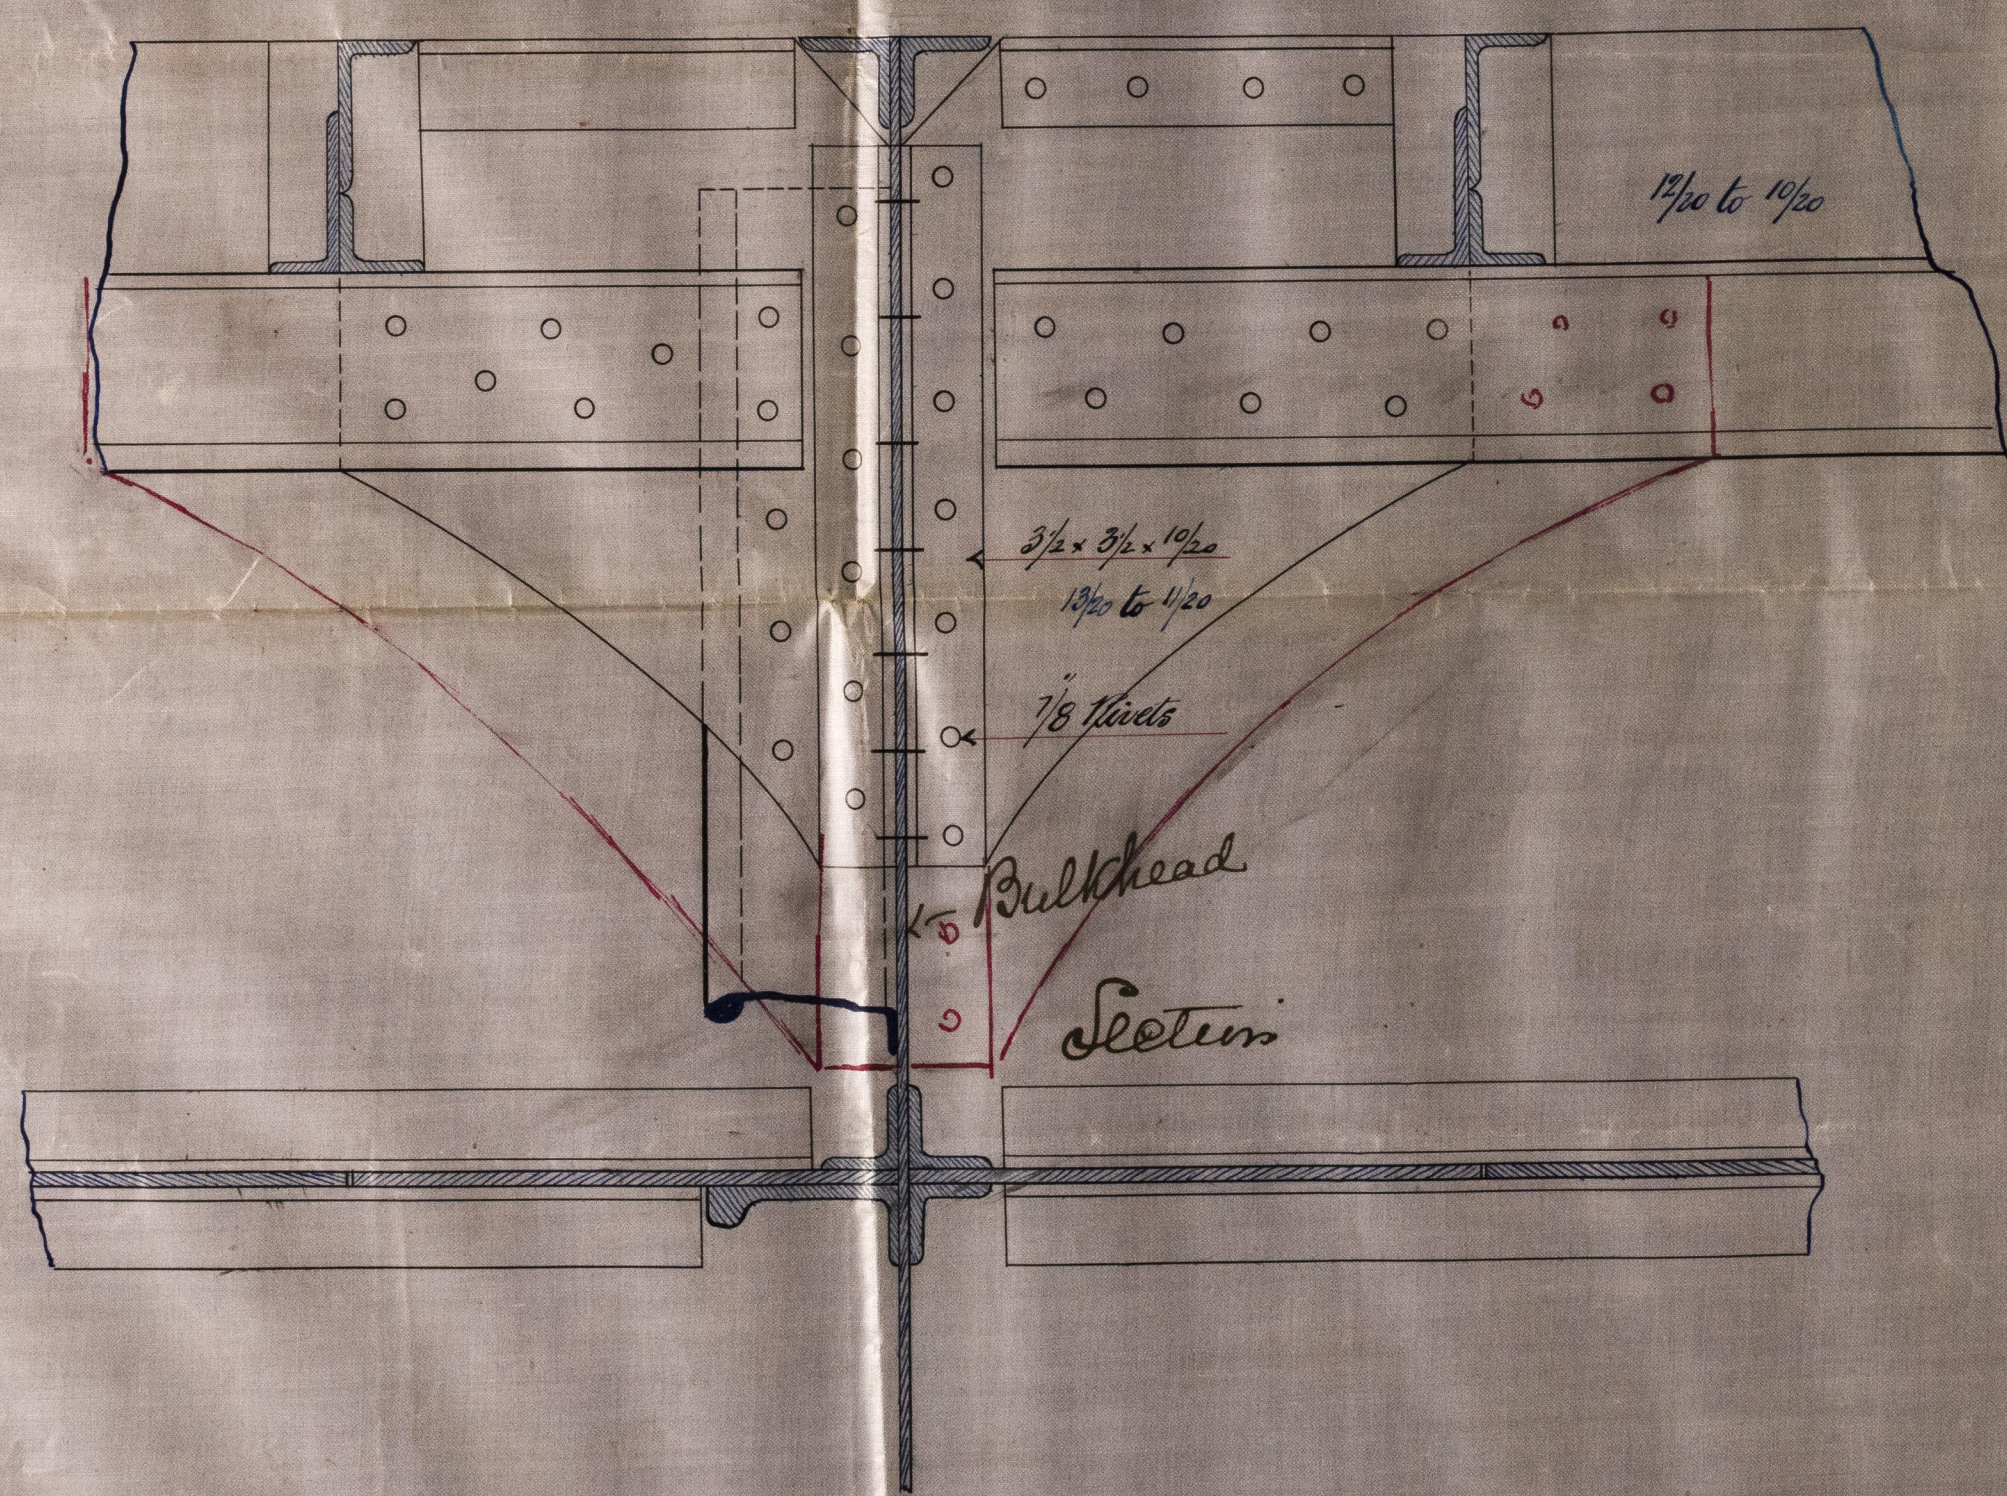

Nos 2 Stringer



J.H.
10/6/95




J.H.
10.6.95



© 2019


BEL66-0219

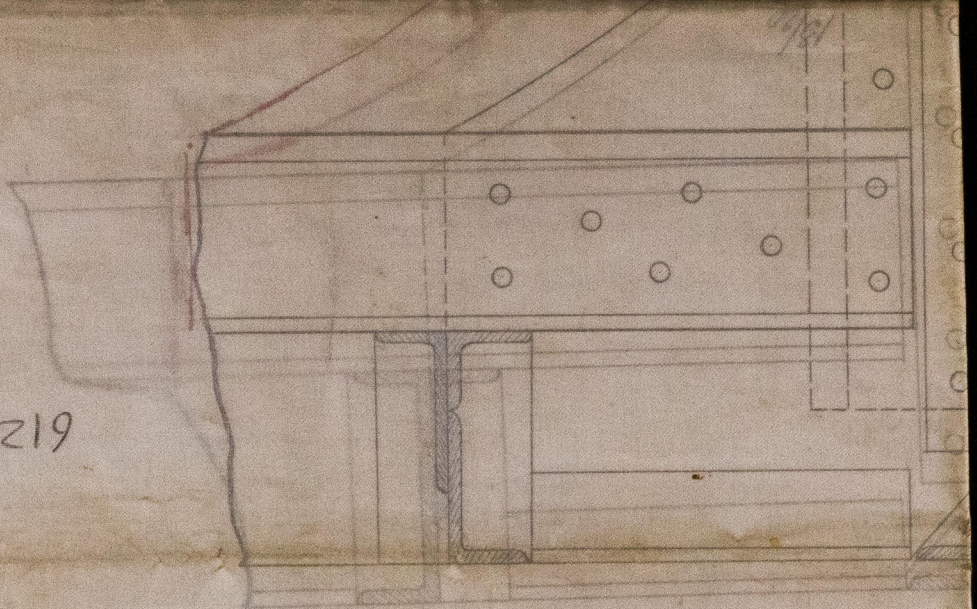

"124" Langton Grange

Belfast Report

10. No 4619



© 2019

Lloyd's Register
Foundation