




29.8.95

Outline Deck Plan of Nos 124 & 125 S.S.

Showing arrangement of Hatches, Portable Beams & Trunks.

Scale 1/8 inch = 1 foot

Handwritten notes: 1st 124 125, 1st 124 125, 1st 124 125, 1st 124 125

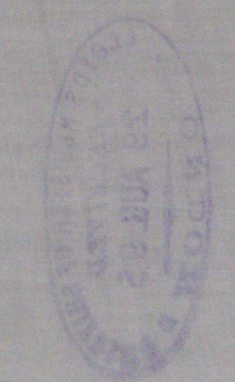








WorRuan Clar RYCo  
Belfast  
124 & 125 S/S  
March ways.


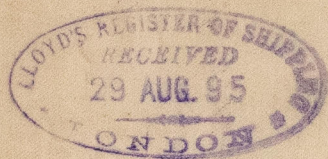


BEL66-0223

"124" Langton Grange

Belfast Report

No. 4619

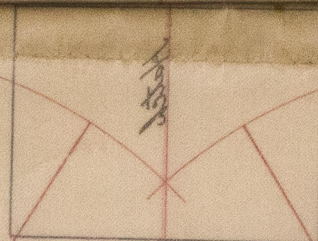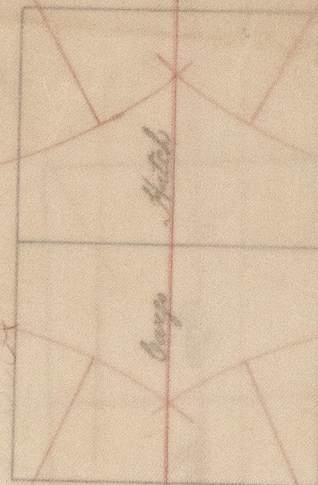

© 2019

Lloyd's Register  
Foundation