




3.5.95

Outline Midship Section of Nos 124 & 125 Is.  
Shewing Arrangement of Hold & Tween Dk. Pillars  
Scale  $\frac{1}{2}$  inch = 1 foot.



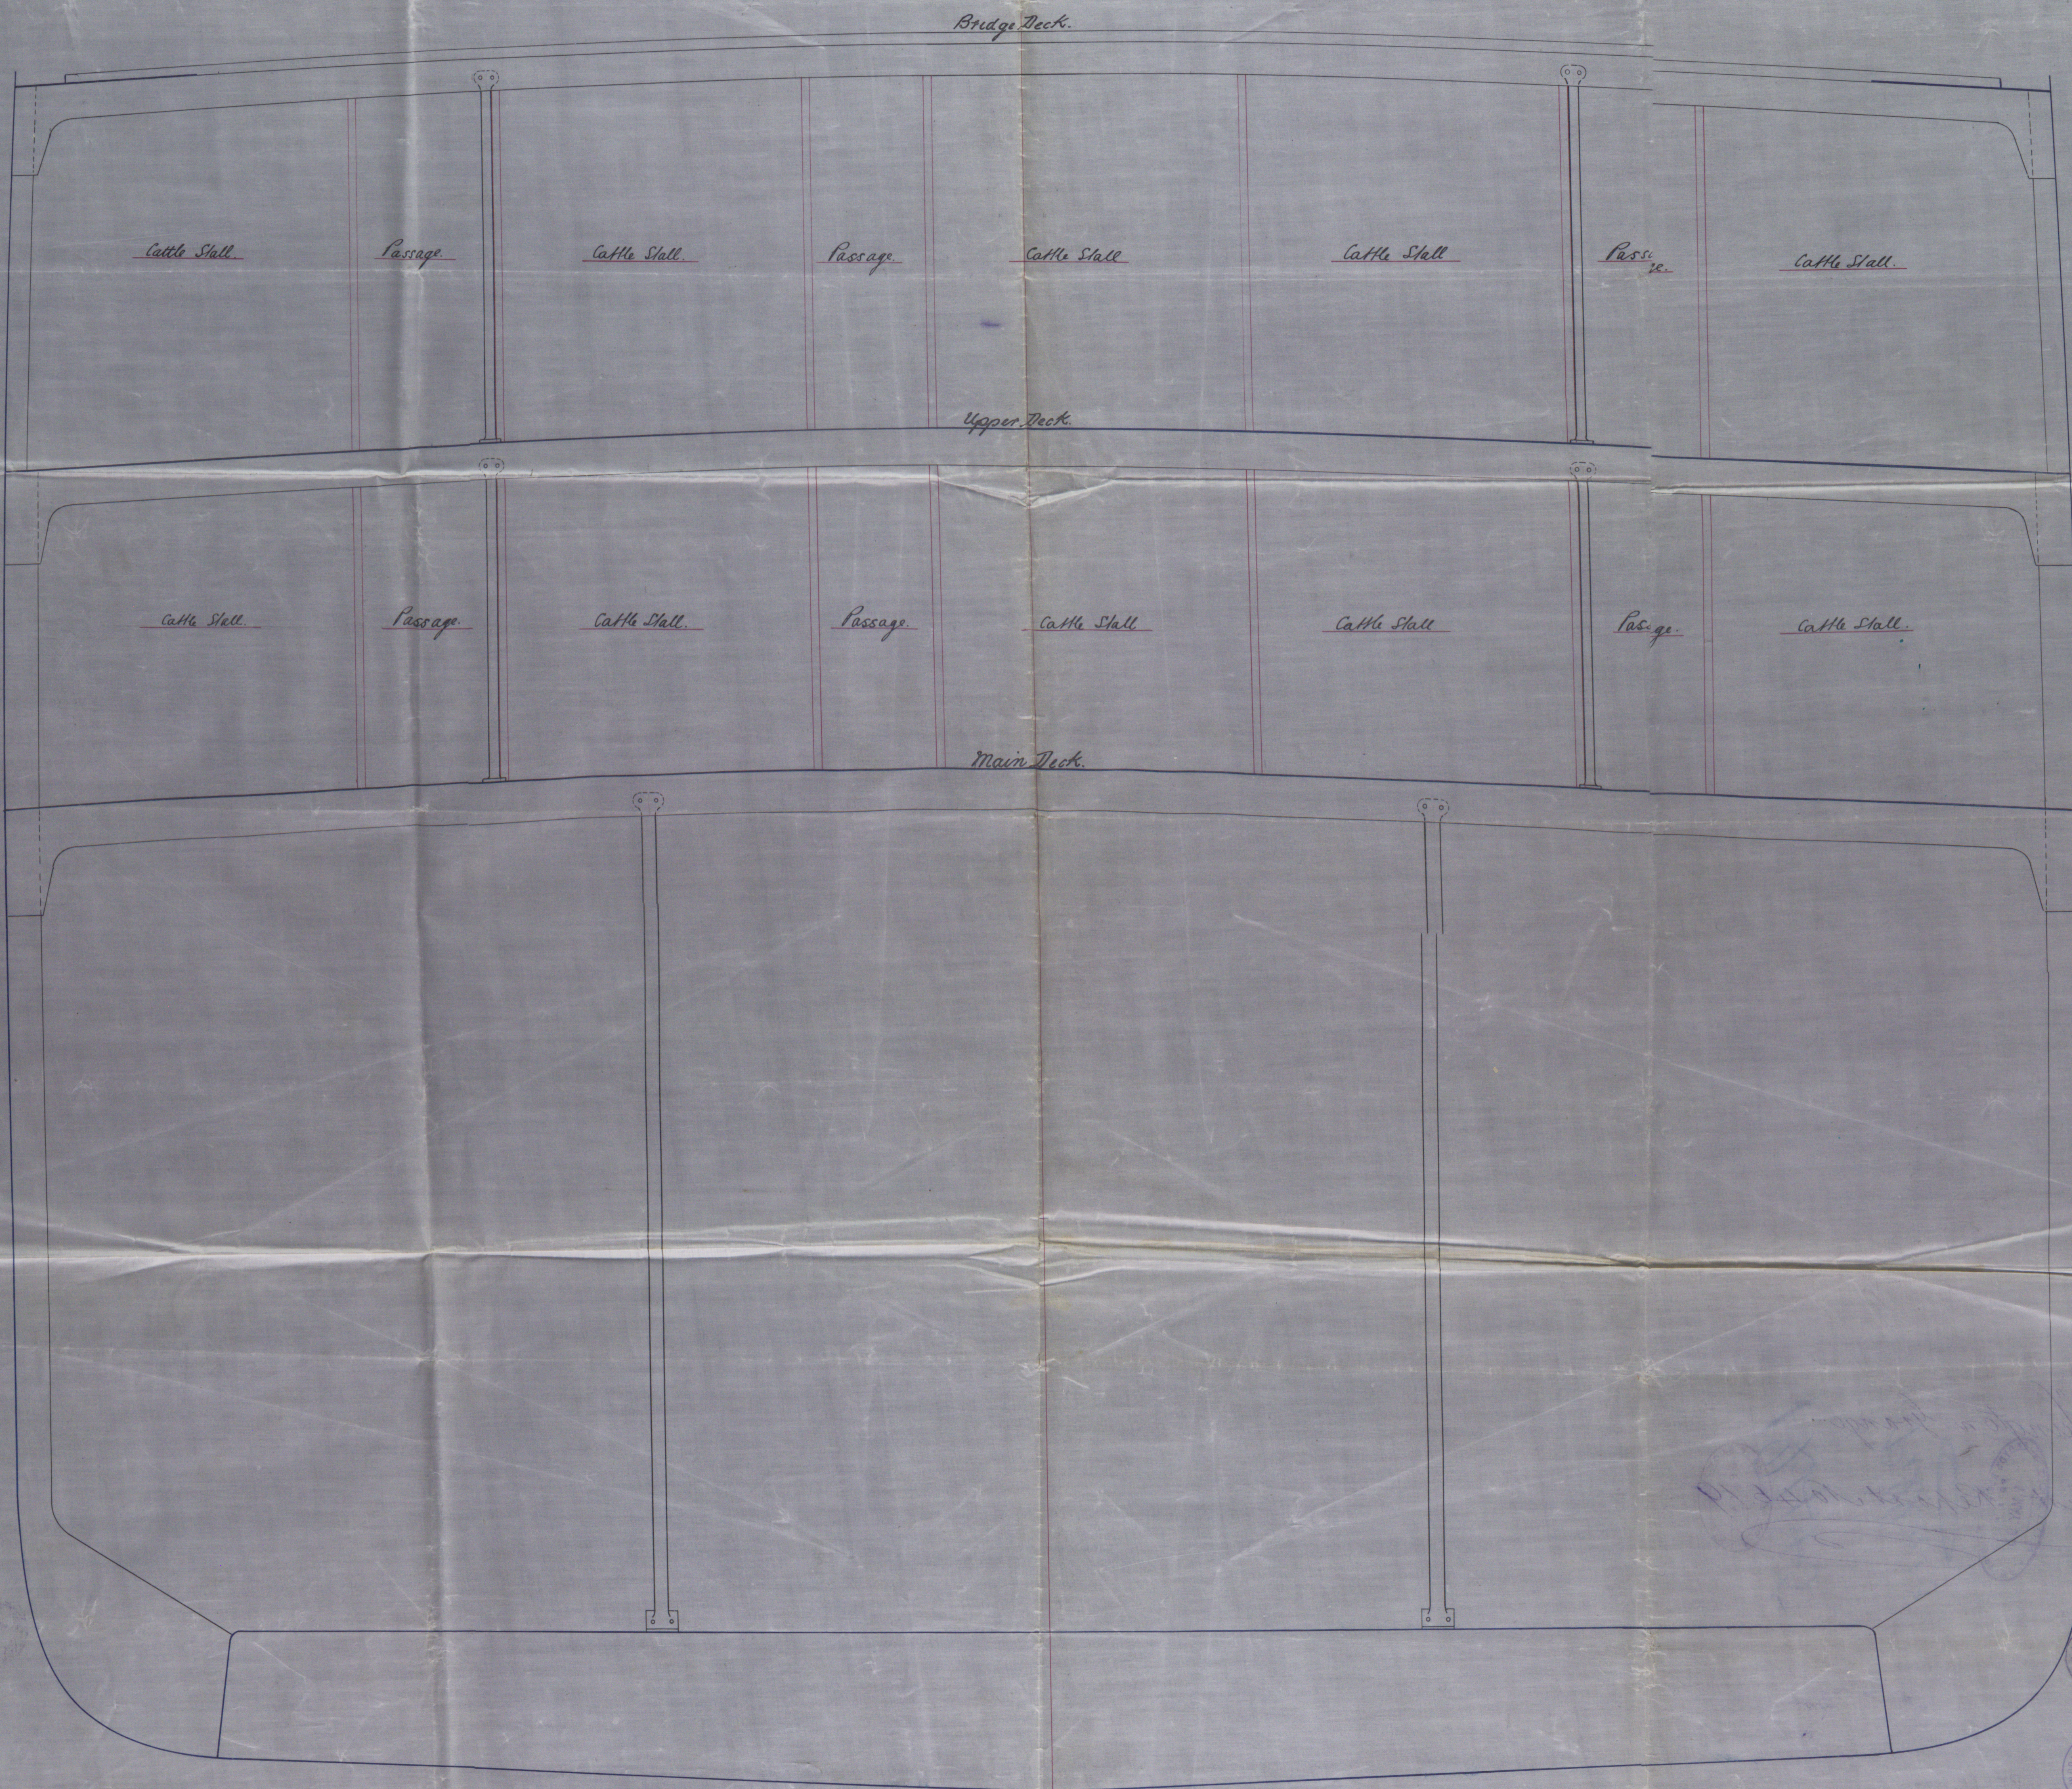


3.5.95



124 Langton Grange

Belfast Report No 46. 19

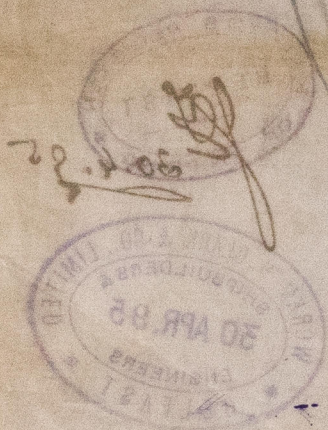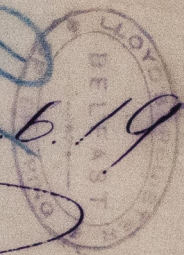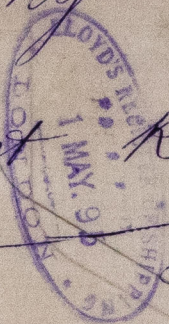

BEL66-0225

BEL66-0225



© 2019

Lloyd's Register  
Foundation