




3.7.95

9th April  
Mr. J. H. ...  
...

Handwritten notes in cursive script, likely describing the ship's specifications or the drawing's context.

# Masts & Yard of No 124 & 125 S.S.

Scale  $\frac{1}{2}$  longitudinally &  $\frac{1}{4}$  vertically - one foot -

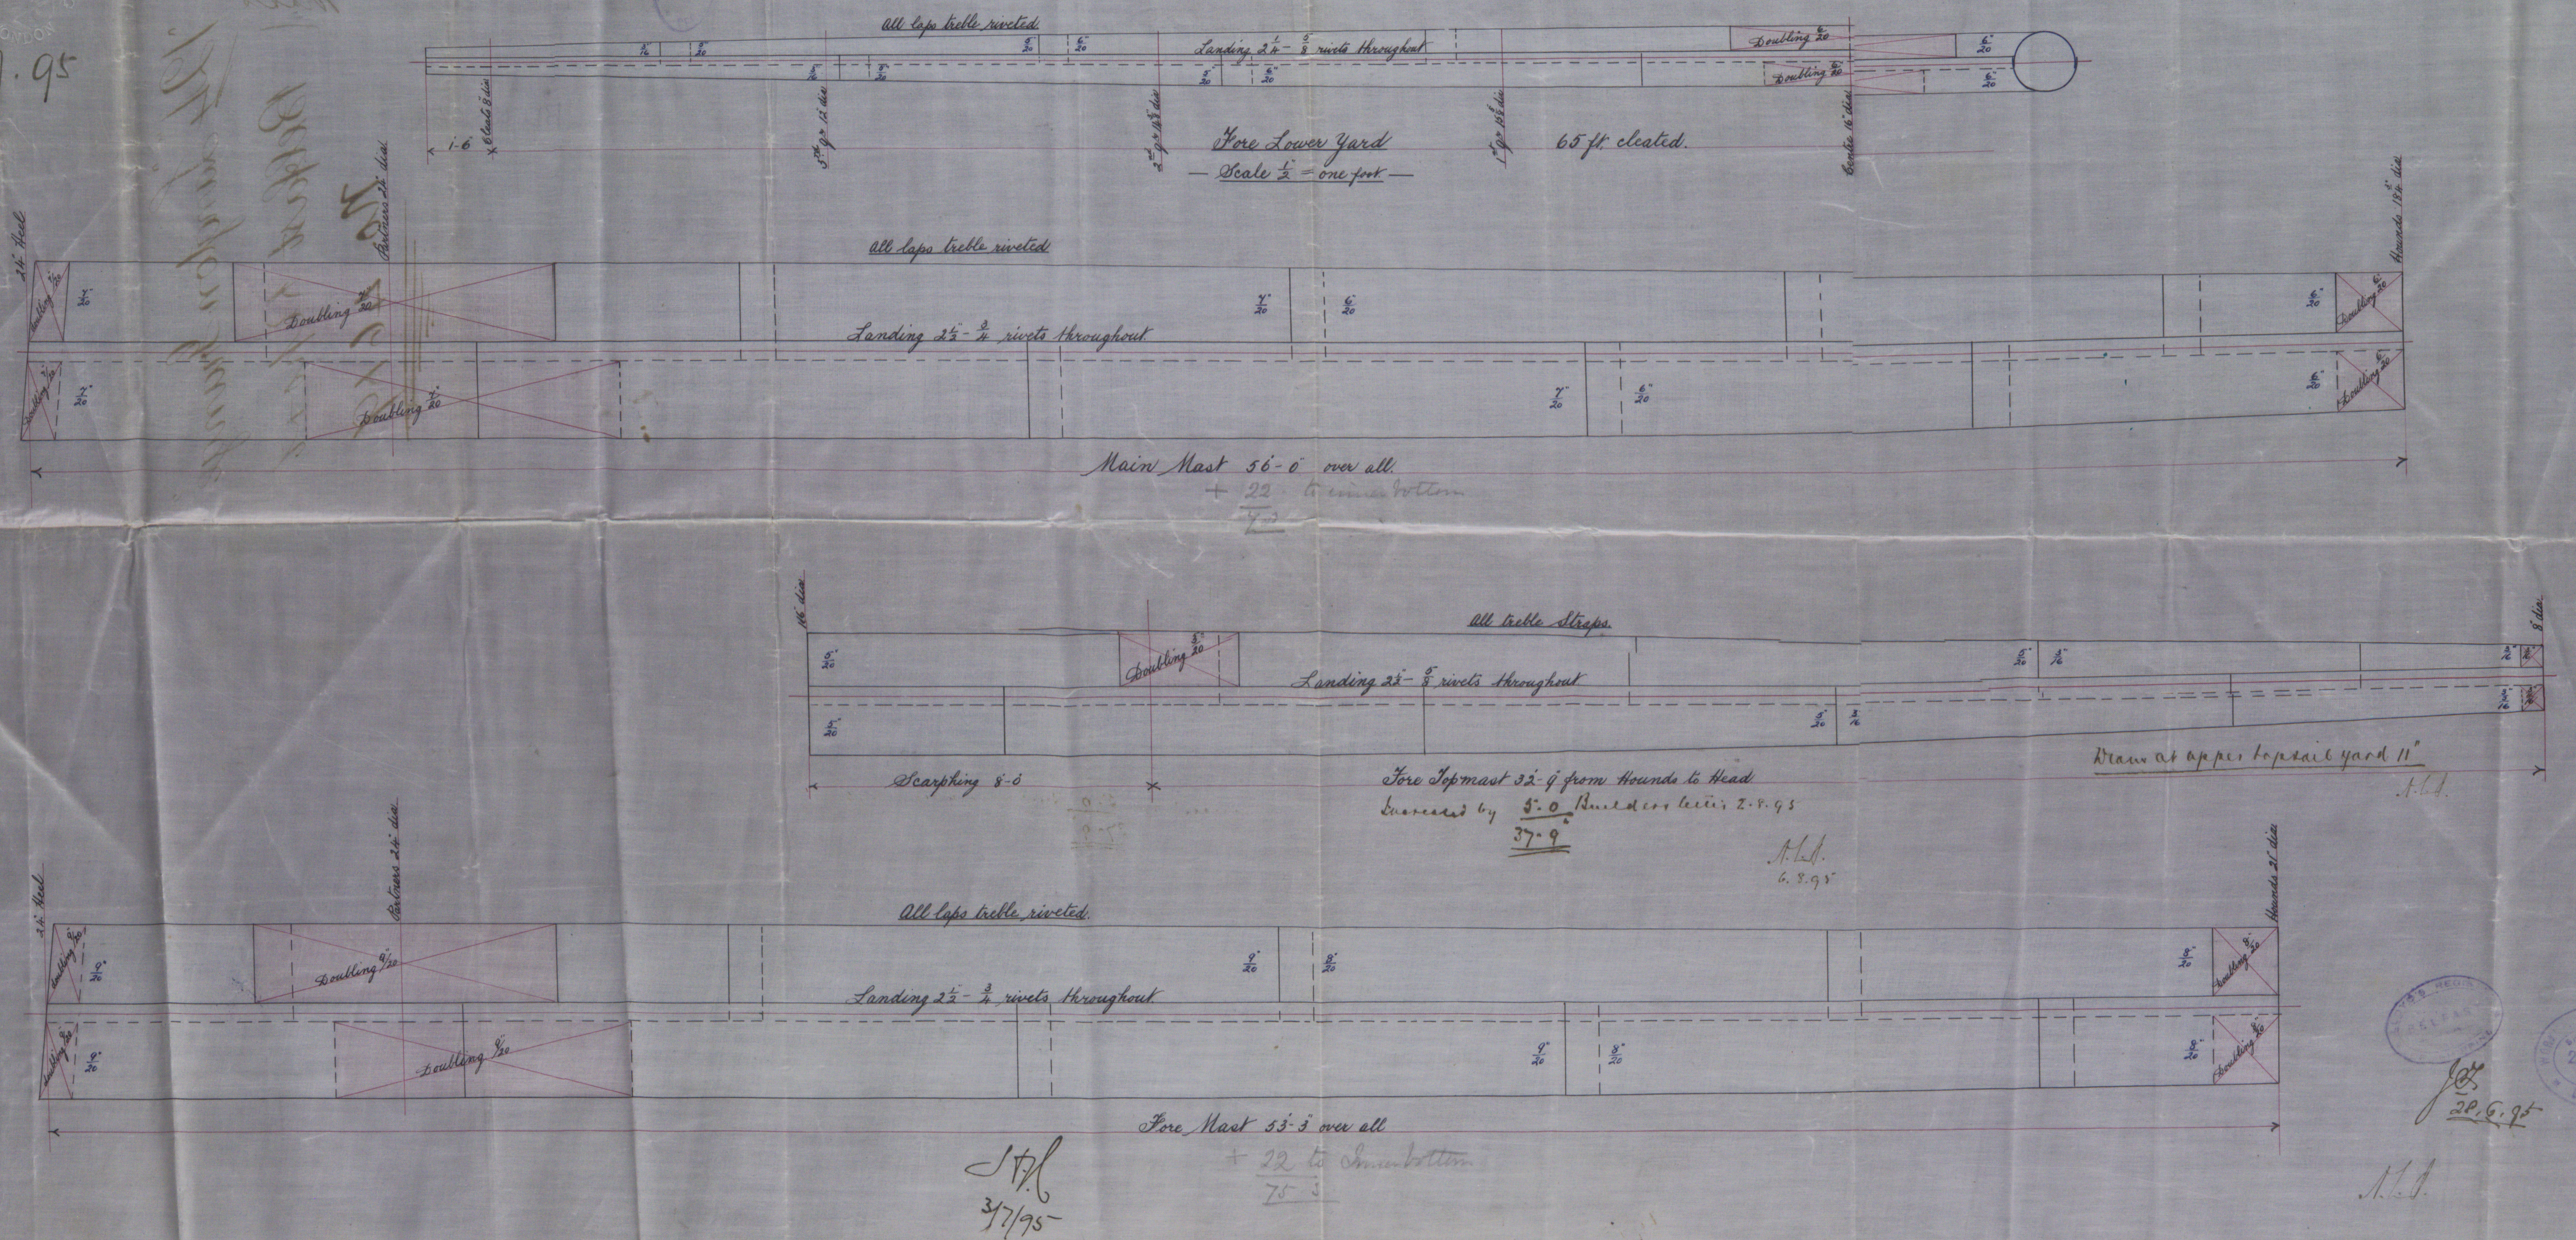

Handwritten signature and date: 3/7/95

Handwritten signature and date: A.L.H. 6.8.95

Handwritten signature and date: J.H. 20.6.95



BE 116-0127



Belfast Rep  
of Langton Grange  
for Emma Clark & Co

No 124

Made

124 "Langton Grange"

Belfast Report

No. 4619

BEL 66-0226



© 2019

Lloyd's Register  
Foundation