


Scale $\frac{1}{2}$ in. = 1 foot.

11. 2. 96
22. 2. 96

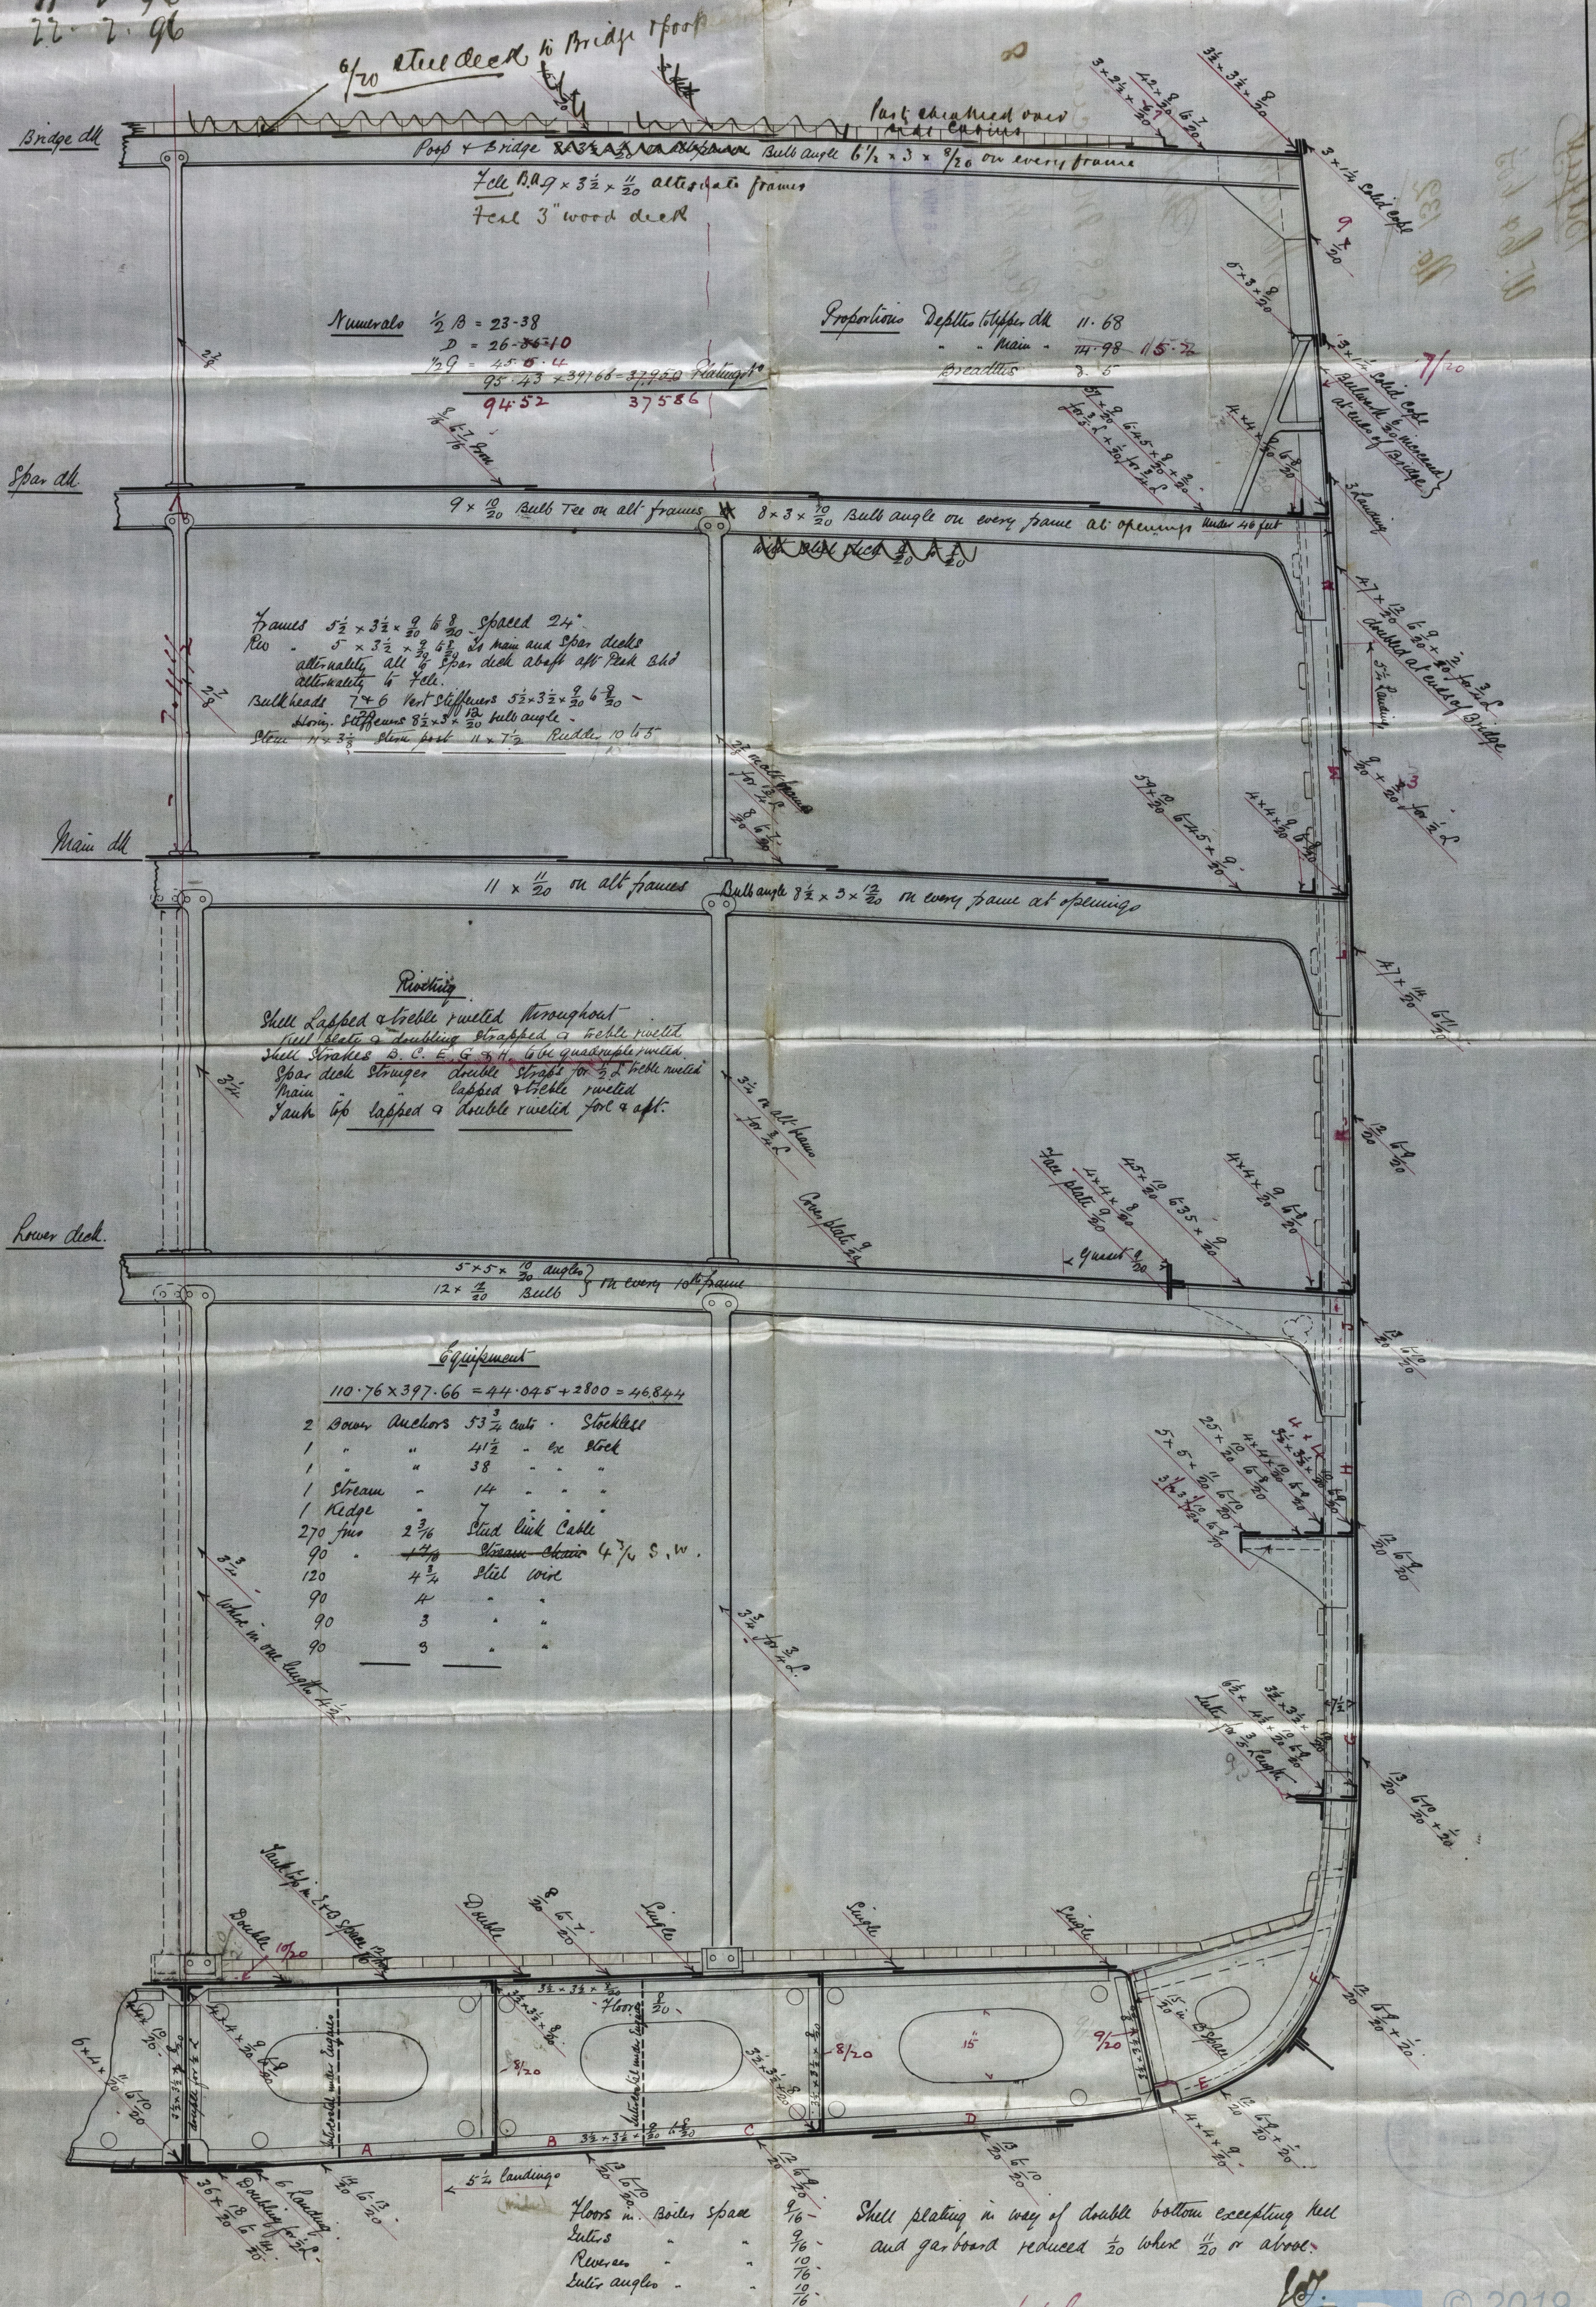

Shell plating in way of double bottom excepting keel and garboard reduced $\frac{1}{20}$ where $\frac{11}{20}$ or above.

J.V.L.
10/2/96

5.2.96

Belfast
W. & Co's

No. 132

BEL 67-0021




Midship
Section

S. S. Majician

Rep. No. 4468



BEL 67-0021

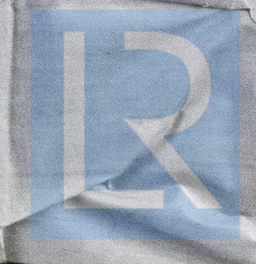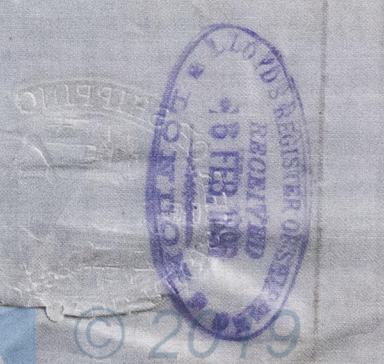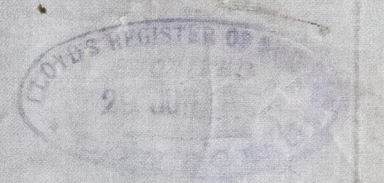

Lloyd's Register
Foundation