





21.5.96

Midship Arrangement of Beams & Deck Plating No 134 I.S.S.
Scale 1/2 inch = 1 foot

Upper deck

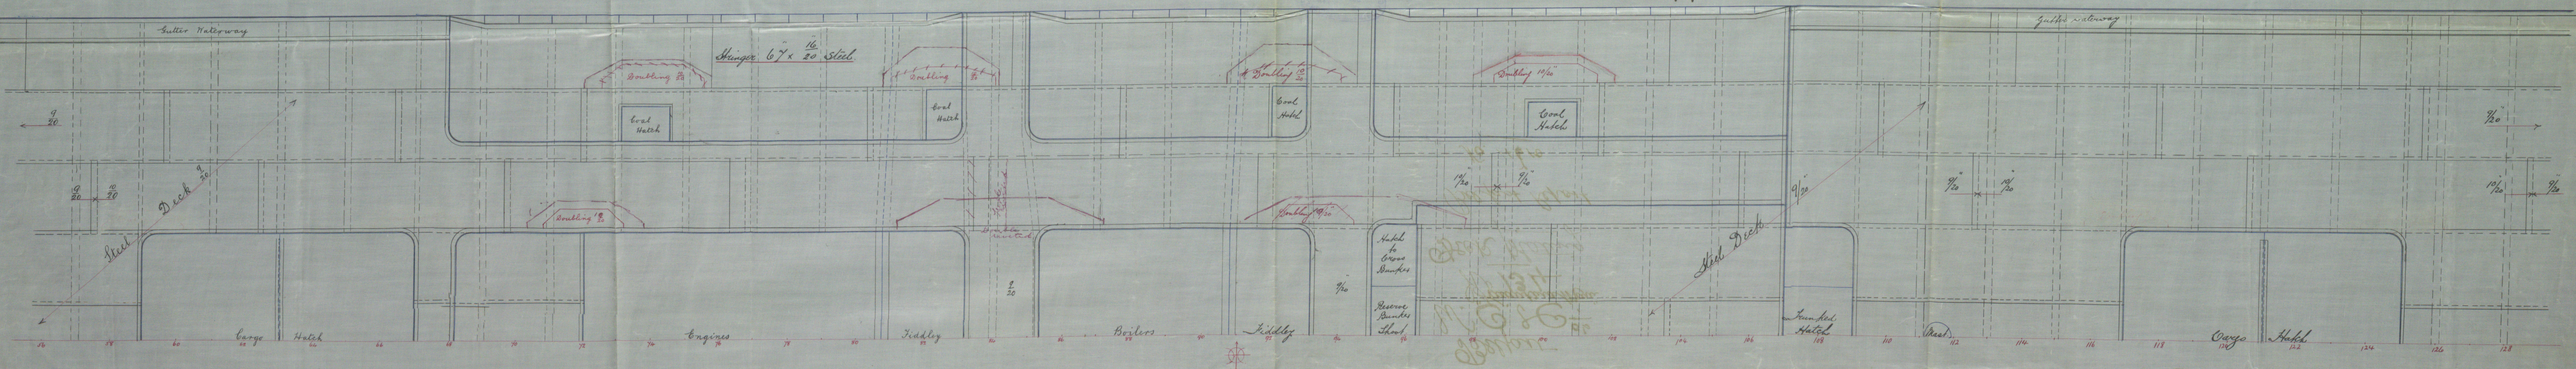

Main deck

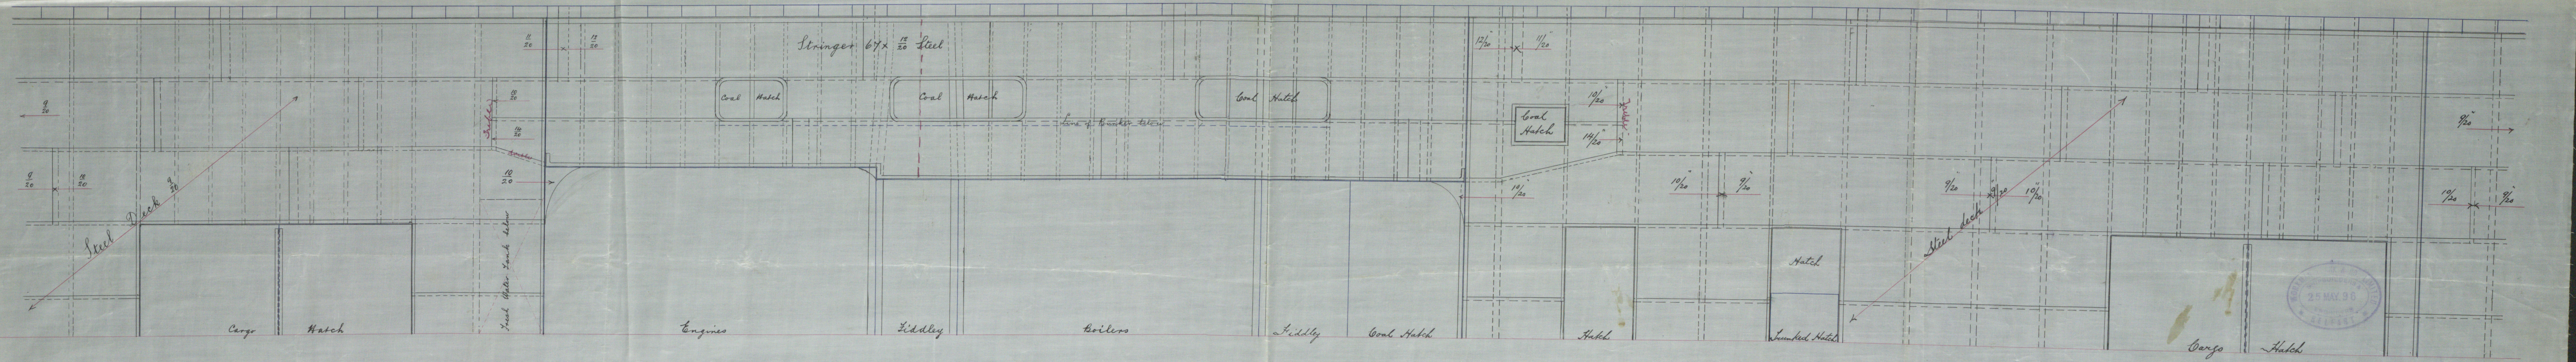

J.V.L.
21/5/96

