


LODD'S REGISTER OF SHIPPING
LONDON

13.7.96

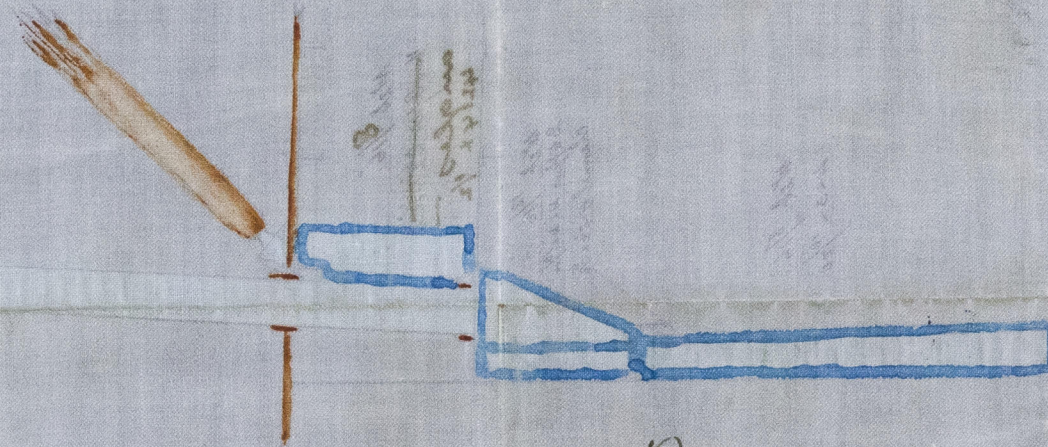

13.7.96

Belfast

W. C. & Co's.

No. 134.

"Kamakura Maru"

Plan showing

Stiffening under

Foremast &

Heavy Derrick

Belfast Report

No. 4410

LODD'S REGISTER OF SHIPPING
RECEIVED
11 JUL 1896
LONDON

LODD'S REGISTER OF SHIPPING
RECEIVED
18 JUL 1896
LONDON

LODD'S REGISTER OF SHIPPING
RECEIVED
8 AUG 1896
LONDON



© 2019

Lloyd's Register
Foundation


0900 - 1911



13.7.96


Plan shewing stiffening under Foremast + Heavy Derrick No 134 V.P.S.

Scale 1/8" = one foot.

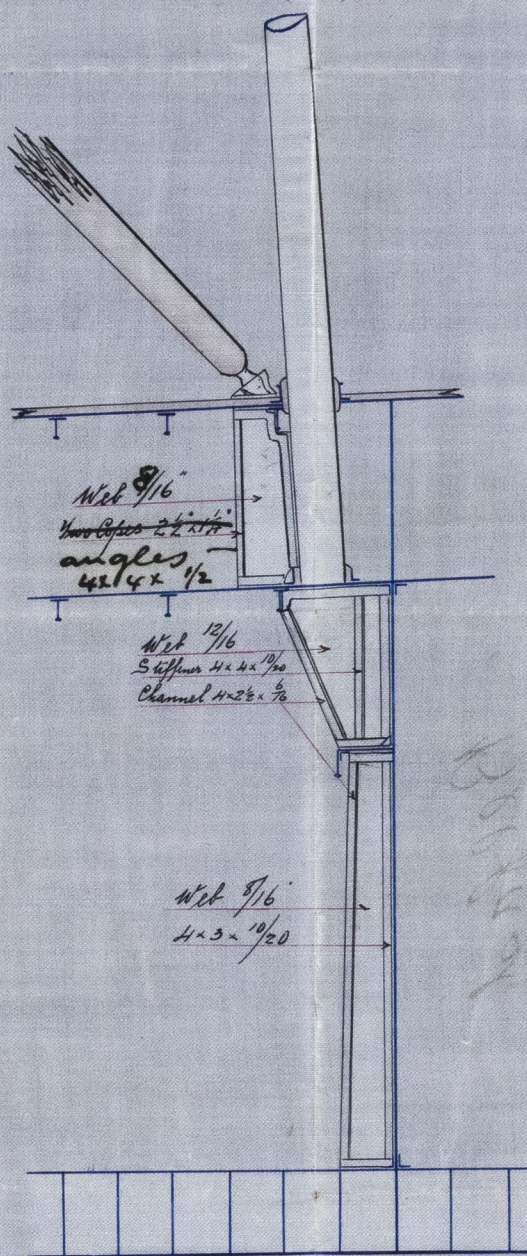


Handwritten signature and date: 13/7/96

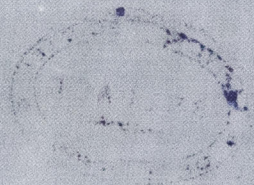

© 2019

Lloyd's Register Foundation

BEL67-0060