




30.3.96

Plan of Forefoot for No 134. T.S.S.

Scale 1 inch = one foot.

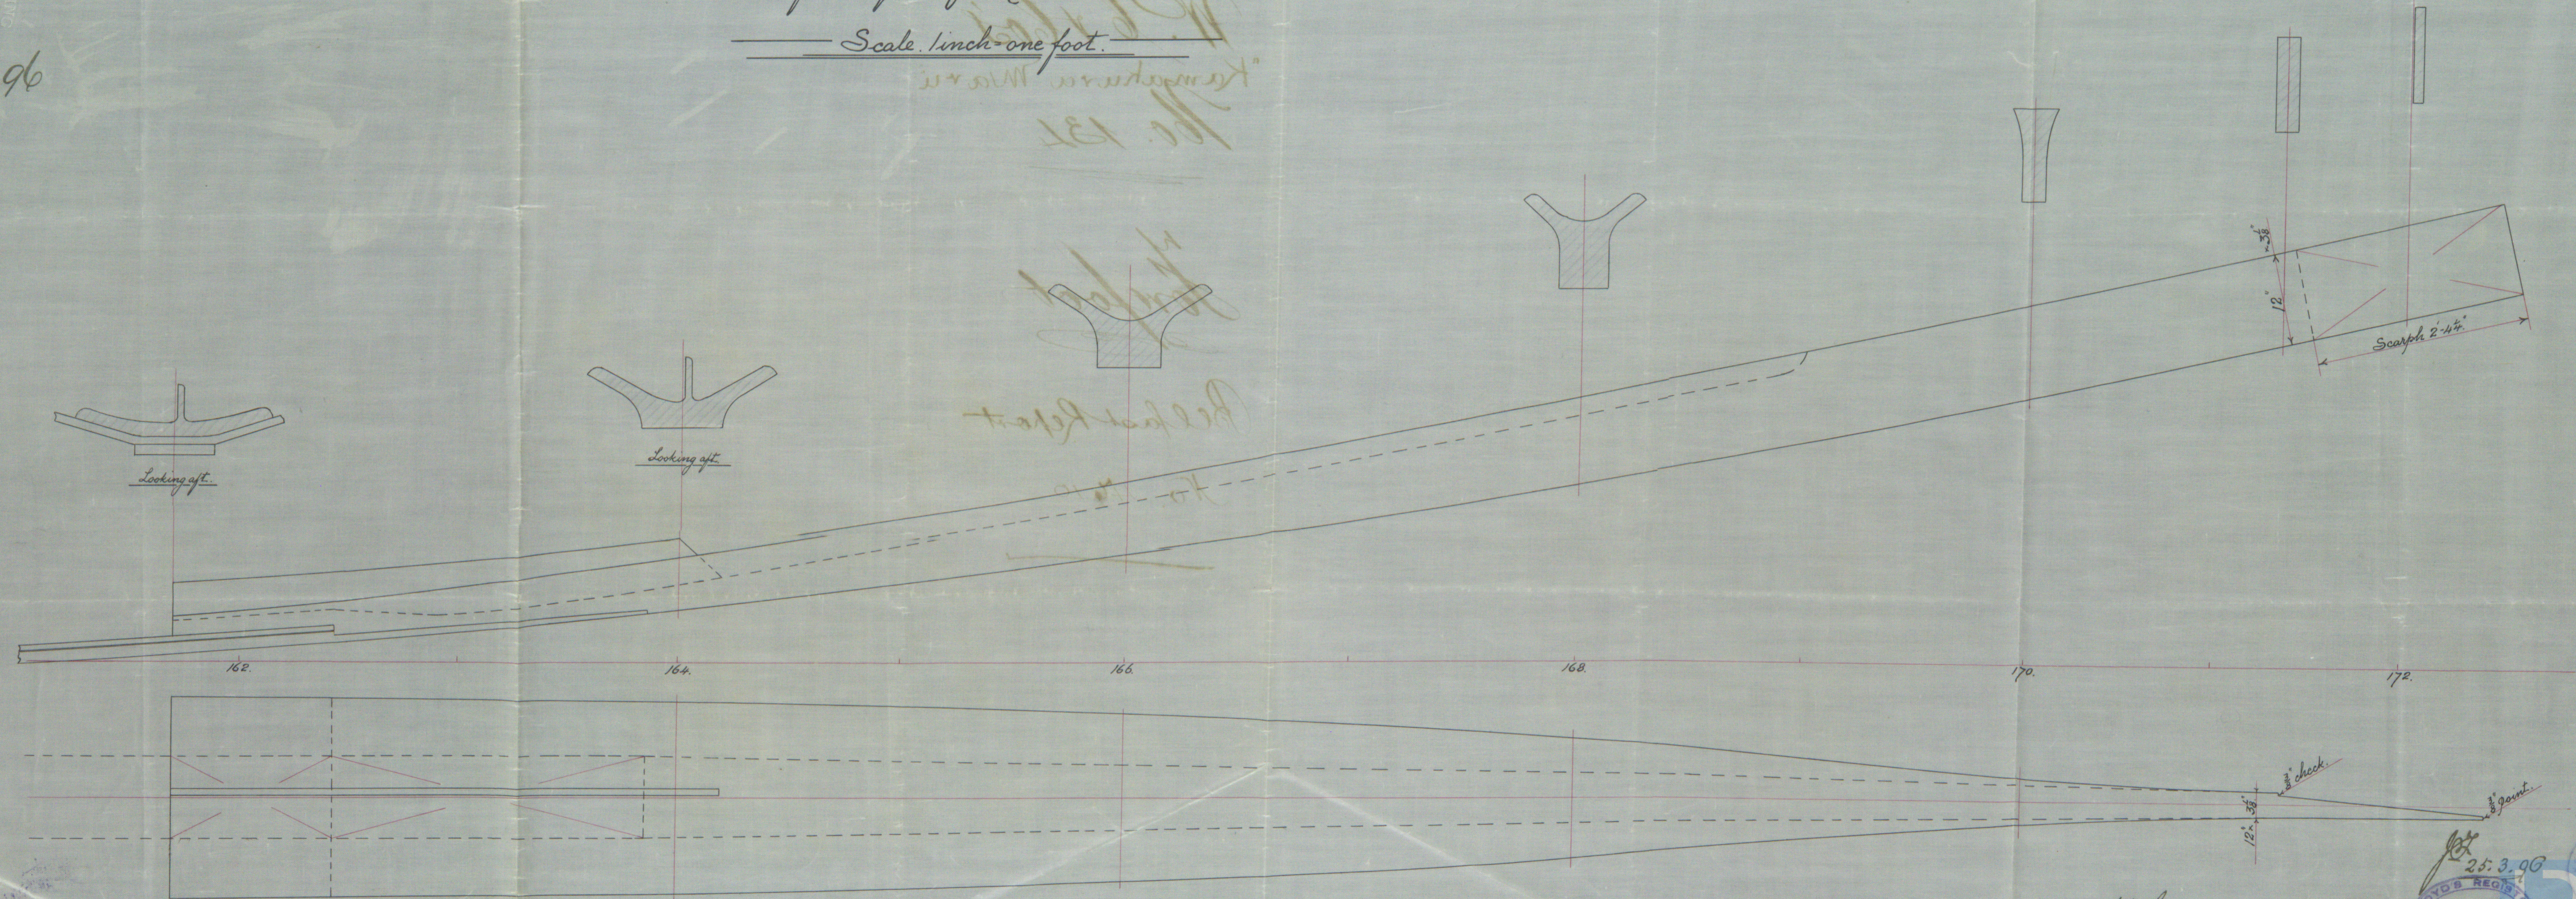

25.3.96  
30/3/96



Lloyd's Register Foundation  
BEL 61-0064



Belfast



W. & Co's

"Kanyakura Maru"


No. 134

Forefoot


Belfast Report

No. 4210

BEL67-0064

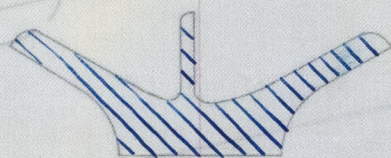

*The forefoot*

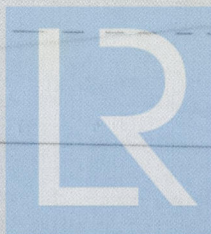

© 2019

Lloyd's Register  
Foundation