

Midship Section of Twin Screw Steamer — No 134

$$\underline{445' \times 49' \overset{4}{\cancel{2}} \times 33' - 6'' \text{ ml}^3}$$


To class 100 A1. 3 Deck rule.

Scale $\frac{1}{2}'' = 1 \text{ foot}$

"Kamakura Maru"

18.	3.	96
30.	3.	96
7.	4.	96
15.	5.	96
21.	5.	96
1.	4.	96

Bridges Deck

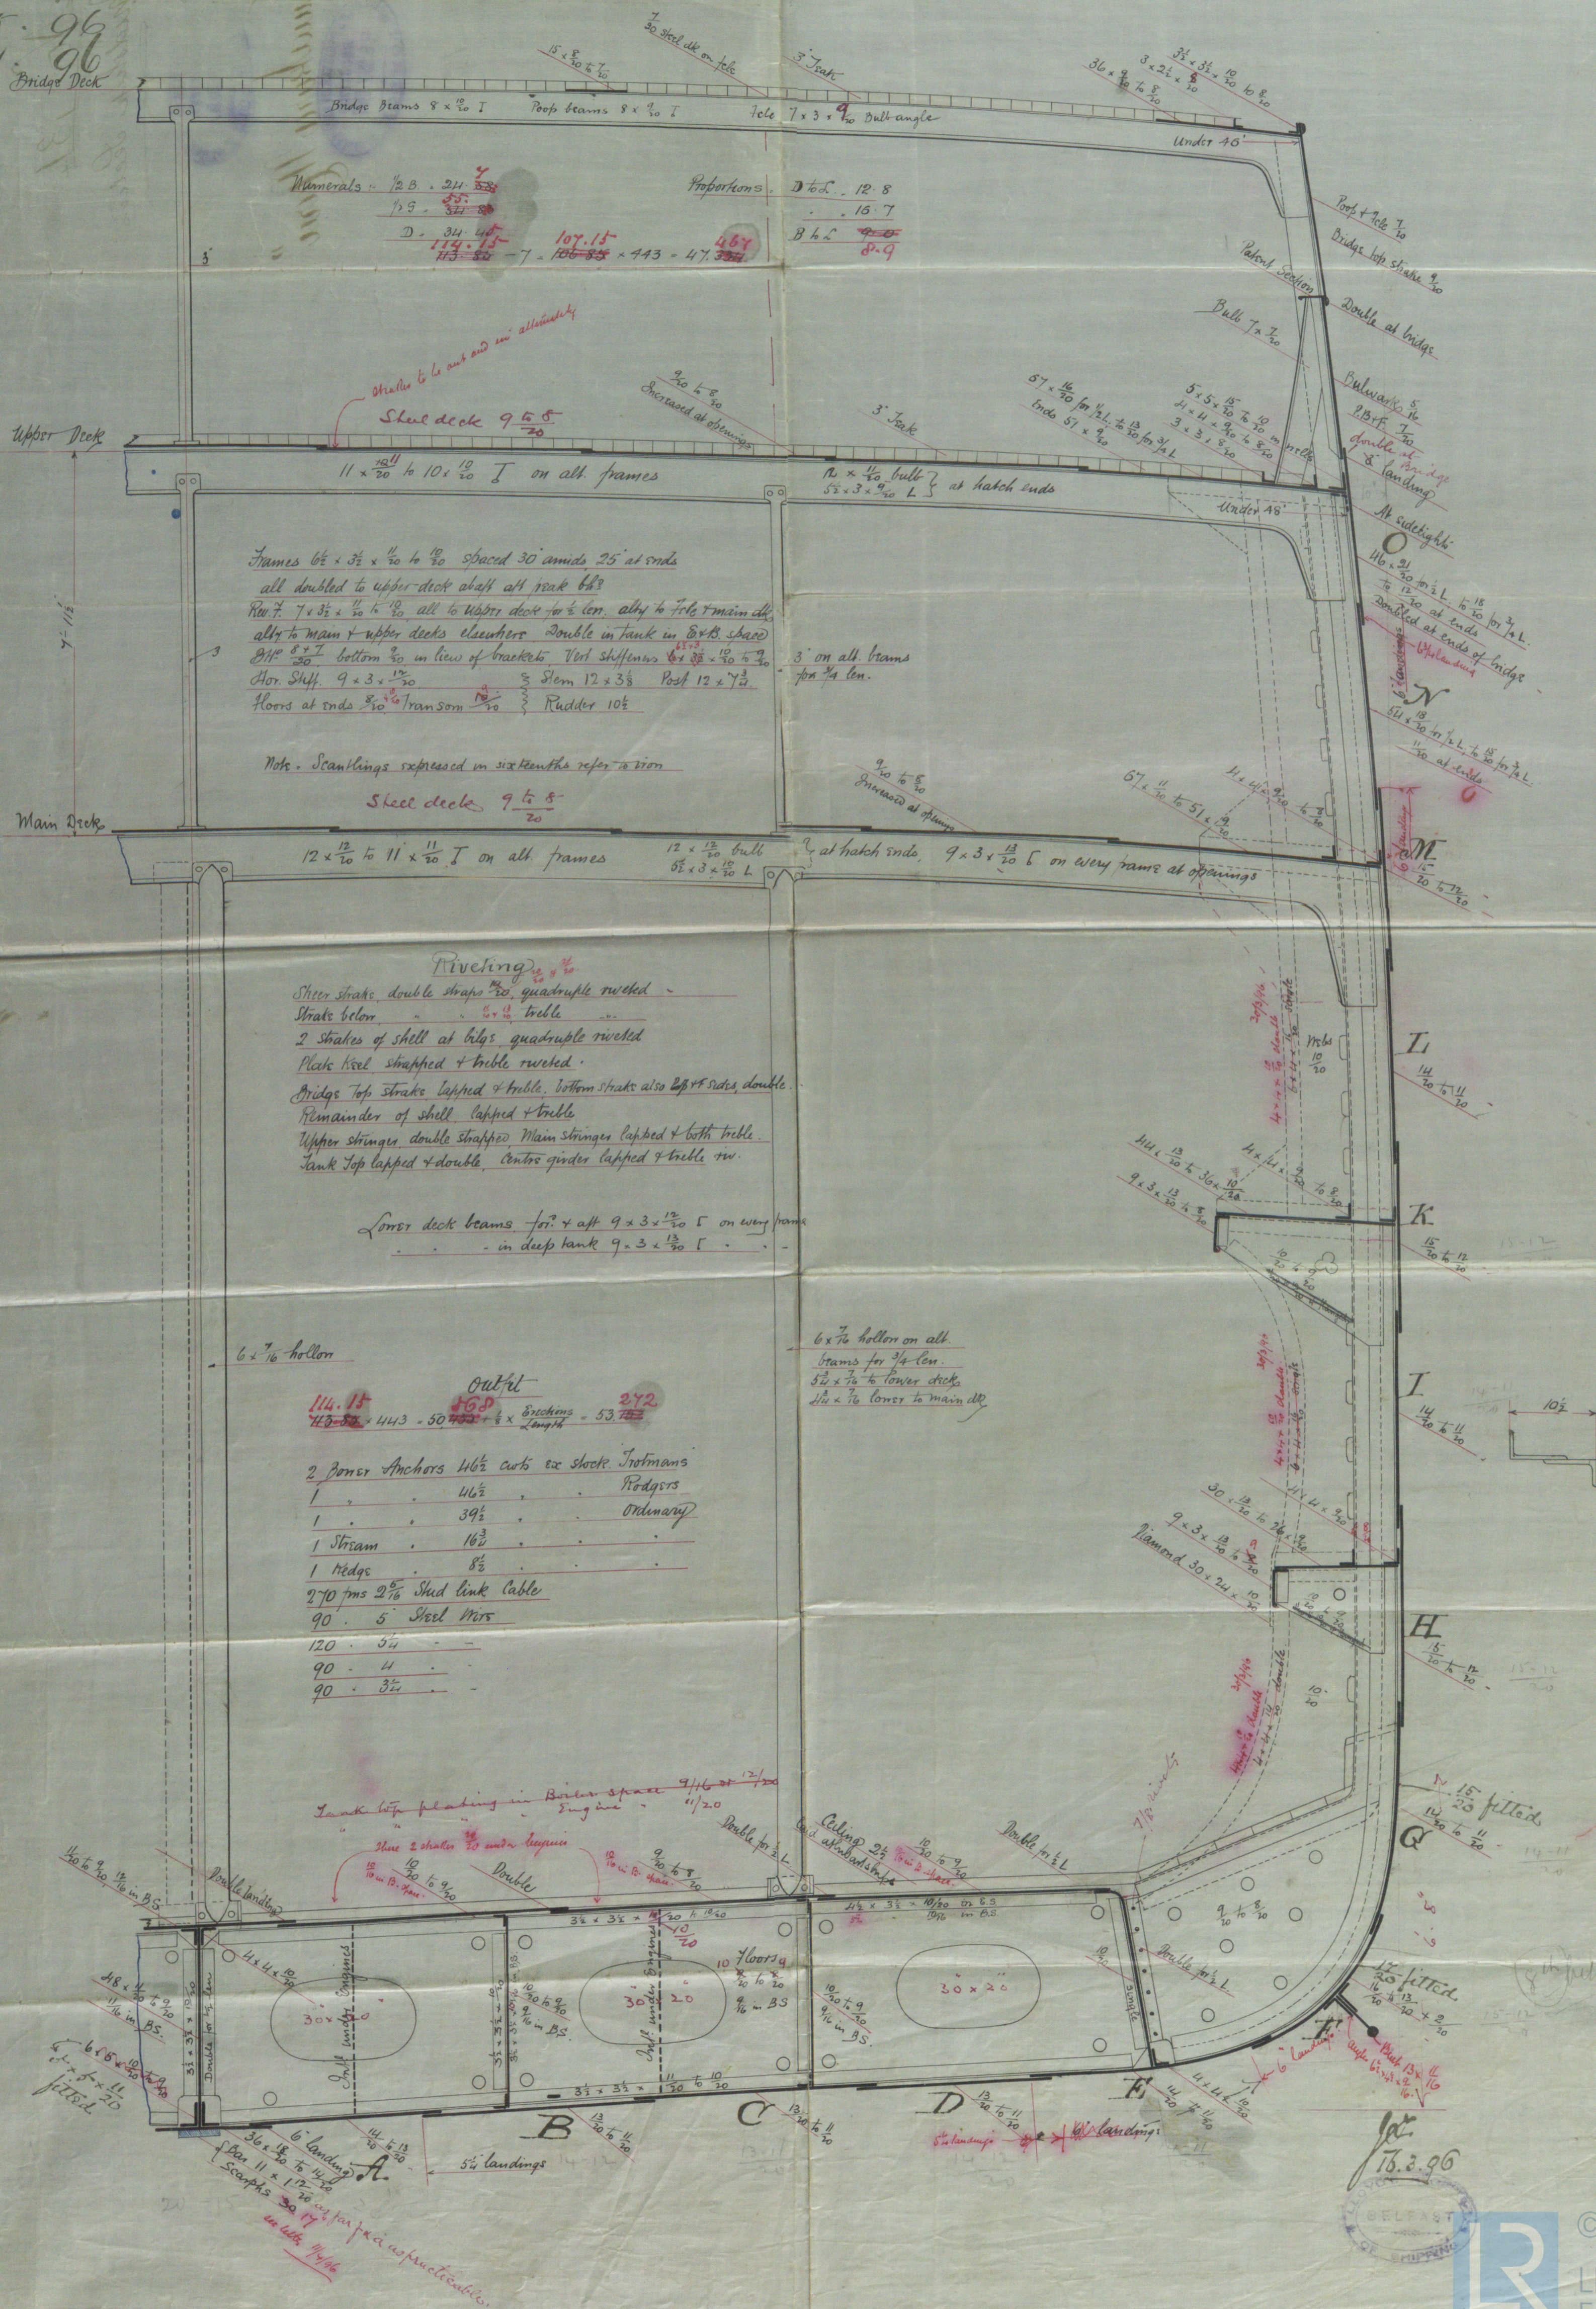

Belfast







W. & A. Co's

No. 134

Midship Section

"Hauakura Maru"

Bel 4410

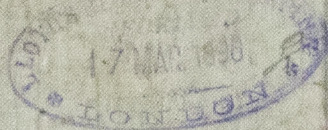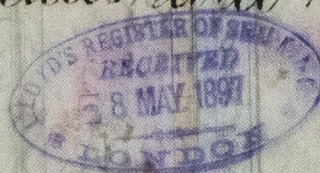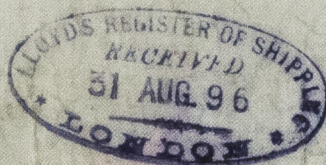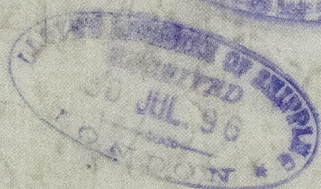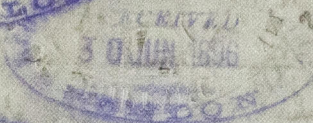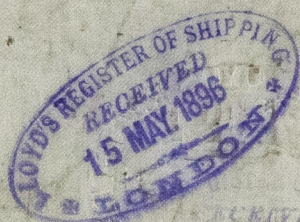

© 2019

Lloyd's Register
Foundation

BEL 67-0067