


Longitudinal Elevation of No 140 S.S. "Pavia" also No. 141-2  
 (app'd 10. 8. 96)  
 Scale  $\frac{1}{8}$ " = one foot.

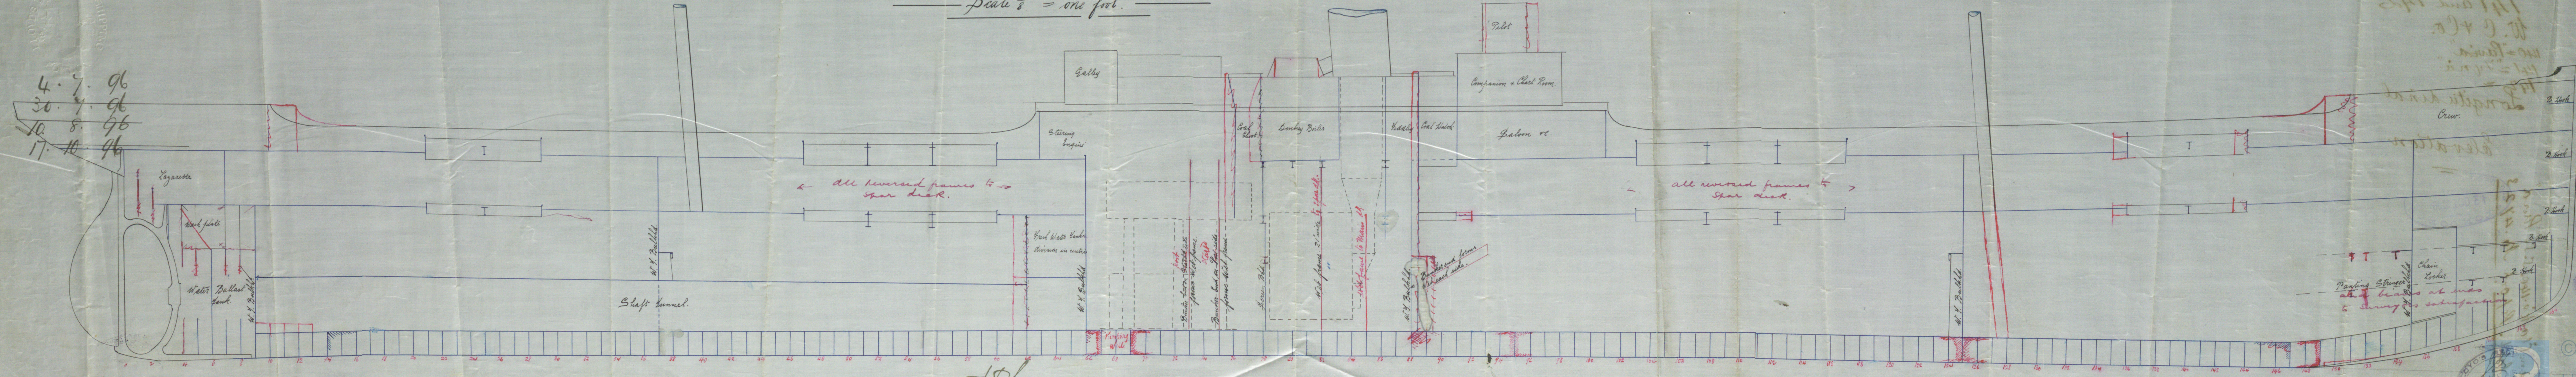

10/8/96  
 3/7/96

Handwritten notes in the top right corner, including 'No 141-2' and 'app'd 10. 8. 96'.

Handwritten notes in the middle right corner, including 'Crew' and 'all reversed frames to spar deck'.

Handwritten notes in the bottom right corner, including 'Chain Locker' and 'Panting Stringer'.



Belfast  
"140" also

141 and 142

W. C & Co.





140 = "Pavia"

141 = "Tyna"

142 =

Longitudinal

Elevation

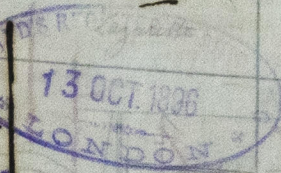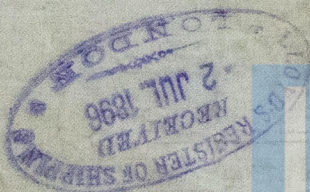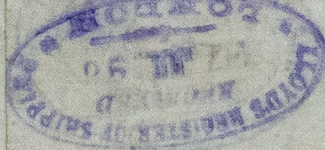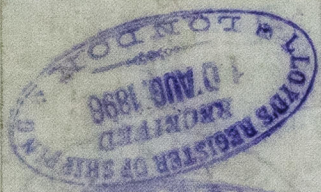

Workman. Clark's 140. S. S. "Pard"

Belfast. Report No. 4723

© 2019

Lloyd's Register  
Foundation

BEL67-0150