


BB67-0169

"Belfast"
"Derbyshire"
Messrs Harland &
Wolffs. No. 314


Section showing
proposed thickening
of tank top
plating under
hatches

Harland & Wolffs
No. 314. S.S. "Derbyshire"
Belfast Report
No. 4770

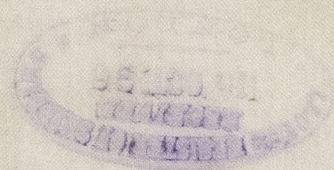

© 2019

Lloyd's Register
Foundation

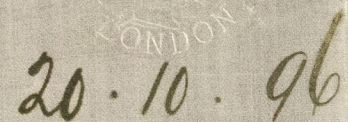

SECTION SHOWING PROPOSED THICKENING
OF TANK TOP PLATING UNDER HATCHES

— SCALE $\frac{1}{2}$ = ONE FOOT. —

170. 2/10
 6. 2. 10
 6. 2. 10
 6. 2. 10



452 p.



B.M.
19/10/96

14.10.96 12/10/96

Lloyd's Register
Foundation
RFL67-0169

REF 67-0169