


Belfast
Report No. 4816
Harland and

Wolffs No. 319
Winifreda
Pumping Plan

BEL68-0051

SCALE - ONE FOOT
PUMPING PLAN
No 319

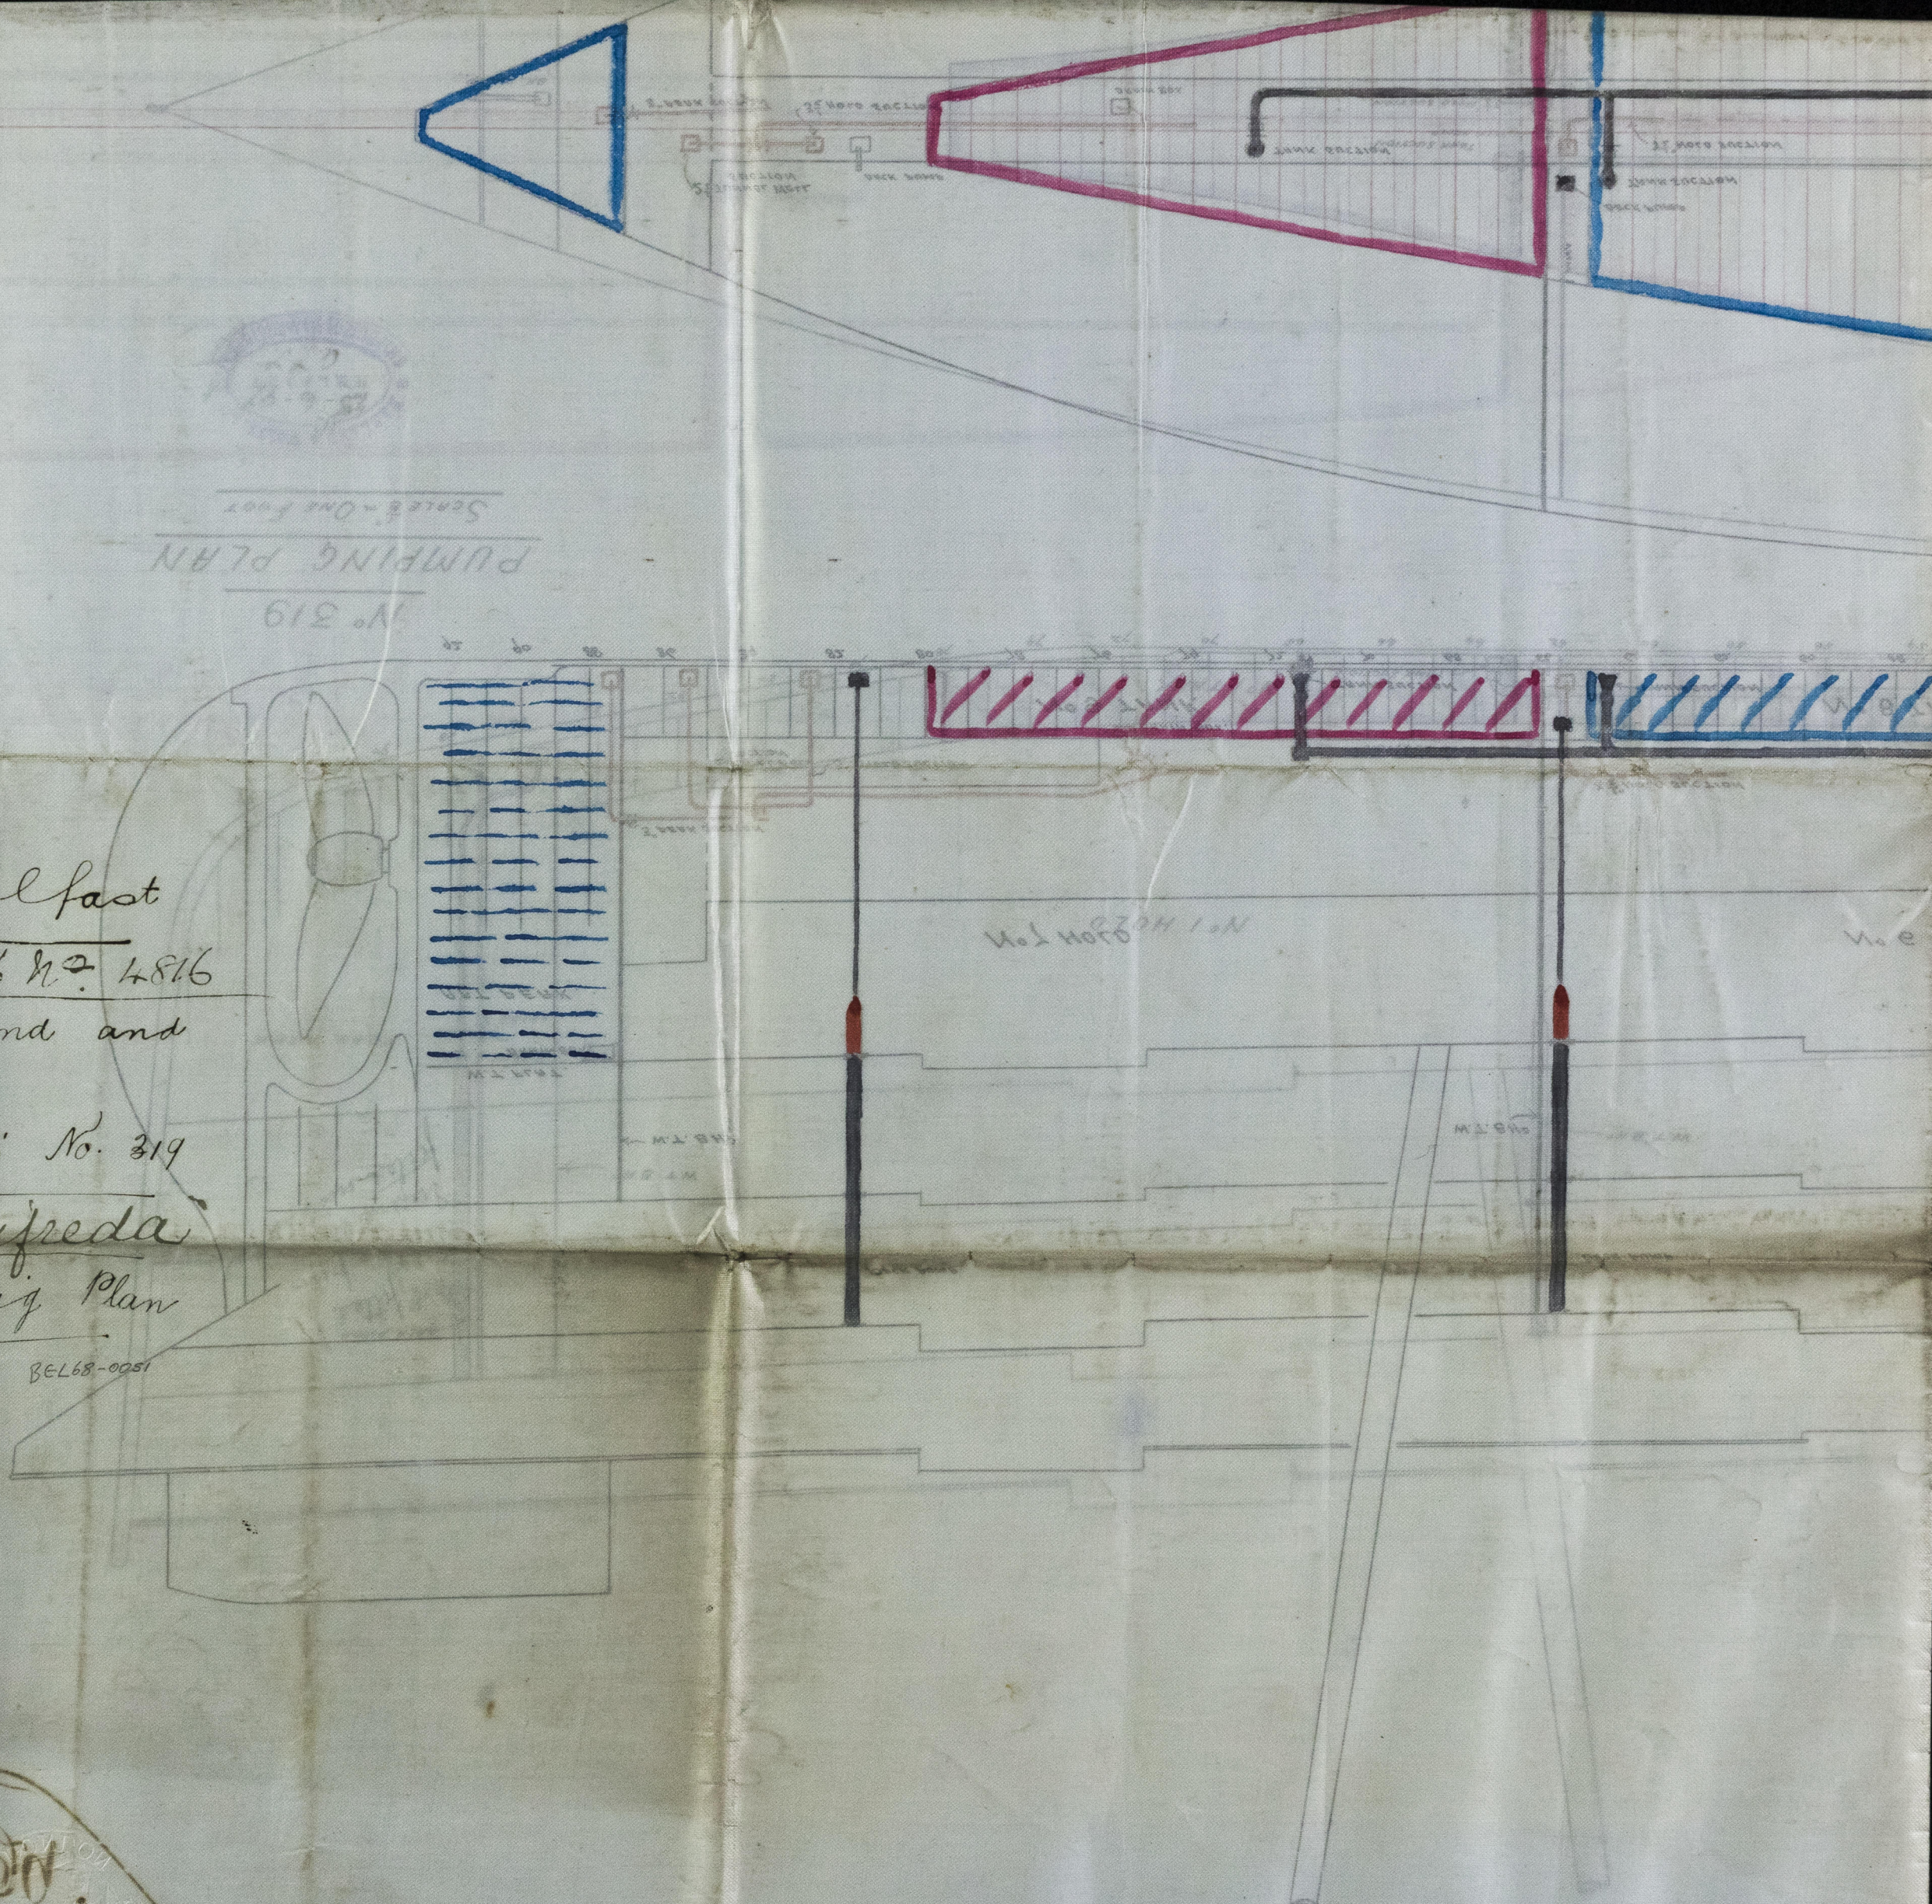



TO THE
LIBRARY OF THE
LLOYD'S REGISTER
FUNDATION



© 2019

Lloyd's Register
Foundation

29.6.97

  

N° 319
PUMPING PLAN
Scale 8'-One Foot





29.6.97

29.6.97