

*Manhattan*

*Liverpool Report*  
*No 46881*



*Bel 4936*

*s/s*

*"Monmouth"*

*Liverpool Report No 45967*

*League with*  
*Belfast Rept. 4847*


BEL68-0098




© 2019

Lloyd's Register  
Foundation



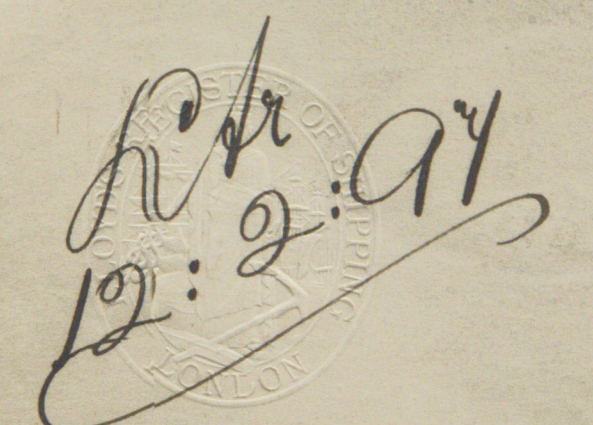


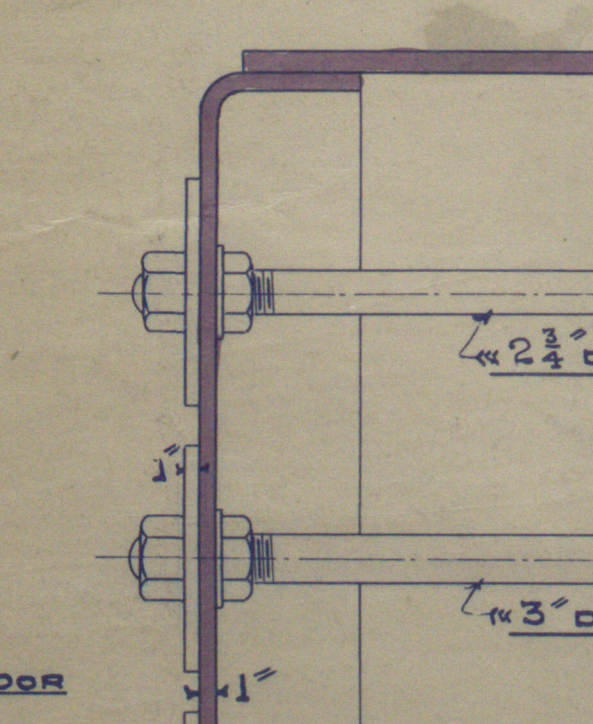

2 OFF FOR ENGINES N<sup>OS</sup> 4150 & 4151  
2 " " " N<sup>OS</sup> 4152 & 4153