
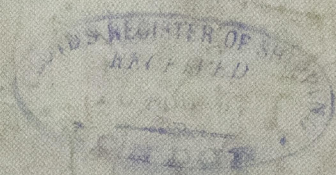
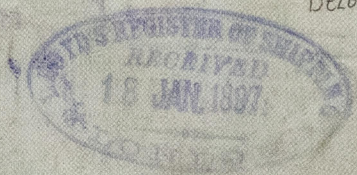


Belfast. 4847

Harland & Wolff  
"B" & Co.  
"Monmouth"  
Longitudinal  
Elevation

BT62-0099

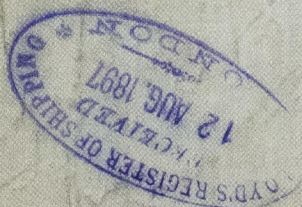

© 2019


Lloyd's Register  
Foundation

BT62-0099



REGISTERED  
SHIP  
1871  
1872  
20.1.97 (A.)  
10.3.97 (C.)  
24.6.97  
13.8.97  
28.8.97

 

LONGITUDINAL ELEVATION - See revised plan.

STEEL 55' 4 1/2\"/>

18 Nov  
20/1/97

2.1.97