


*"B & C" Revised
Longitudinal
Elevation
"Nonmouth" and*

B6L68-0101

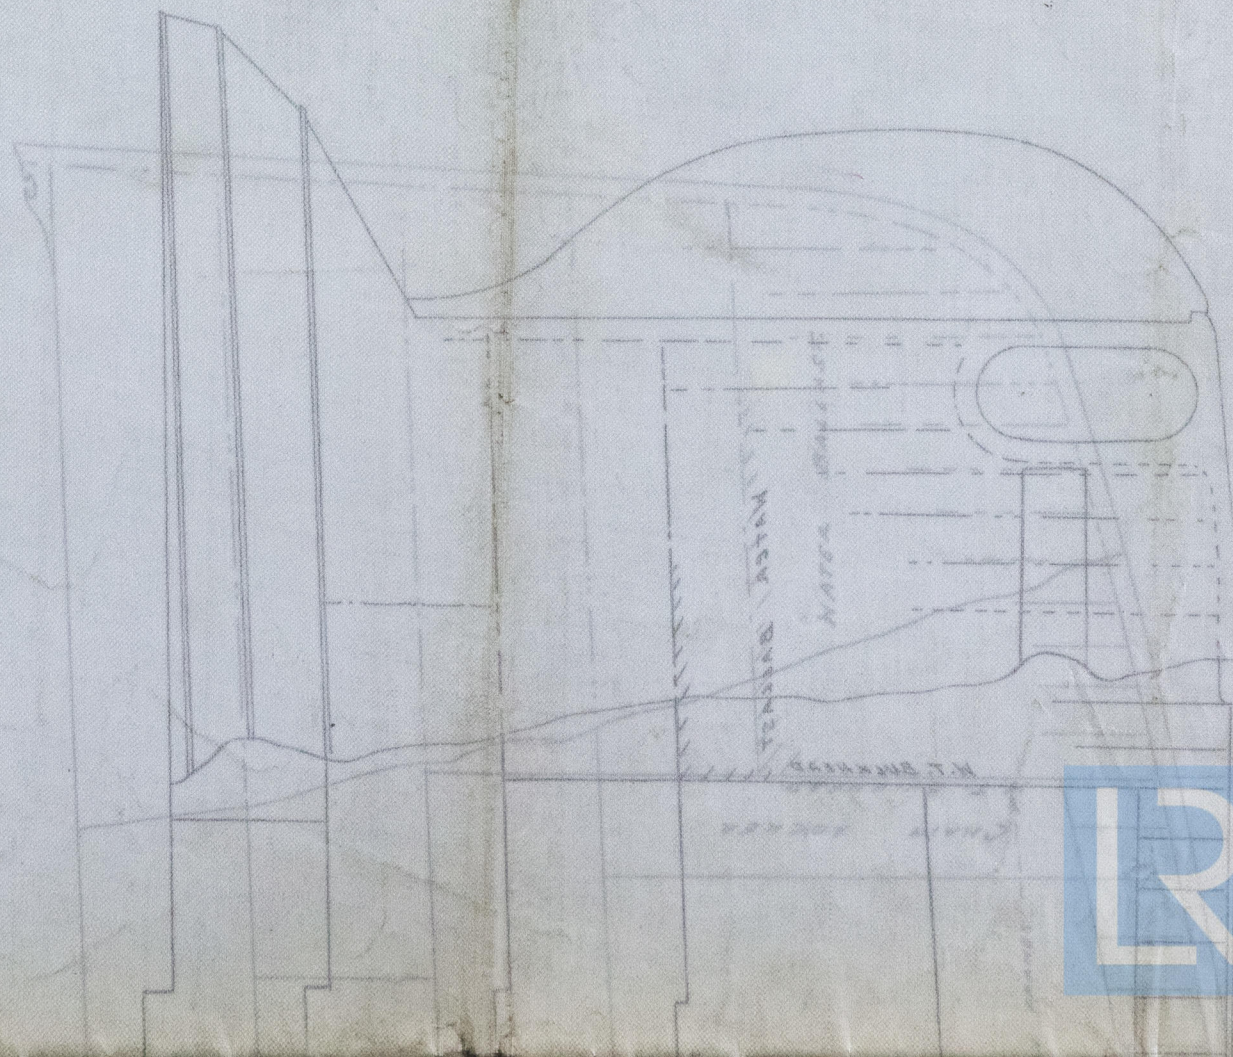

© 2019

Lloyd's Register
Foundation

