




21. 11. 96

Handwritten notes in the top right corner, including the word 'SHEETS' and various numbers and symbols.

Plan showing proposed Compensation on Tank Floors
701-6 SS

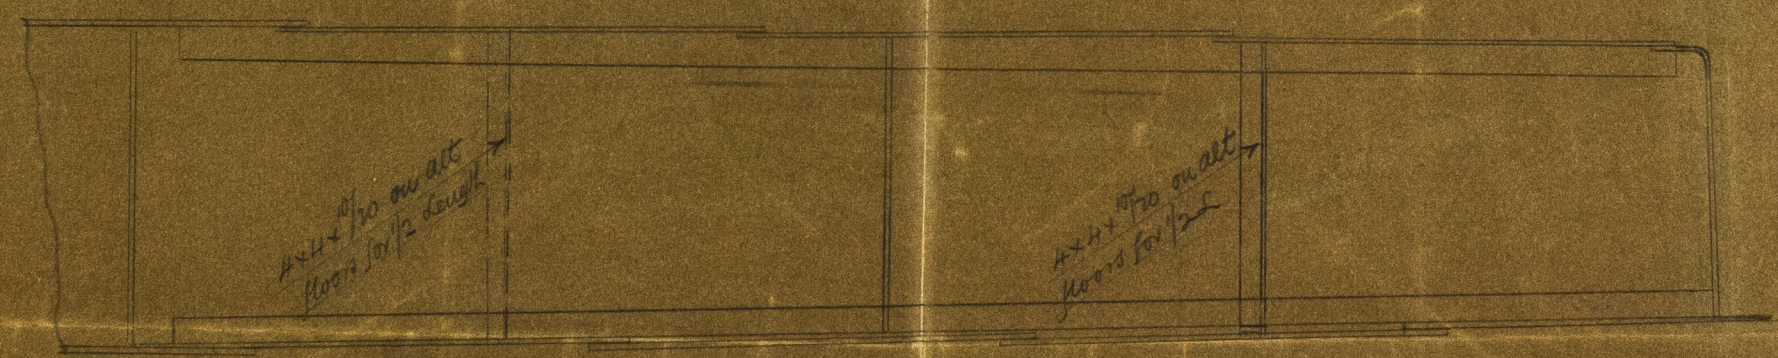

J.H.
21/11/96



© 2011/96

Lloyd's Register
Foundation
Belg. 6191


Belfast

Workman, Clark

& Co. No. 146

Plan showing

Compensation
on Tank floors

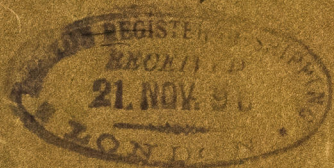

Peacocks
No. 1469

BELF-0141



© 2019

Lloyd's Register
Foundation