


— Scale $\frac{1}{2}$ inch = 1 Foot. —

9. 2. 97
15. 2. 97
27. 8. 97
17. 11. 97
13. 9. 98

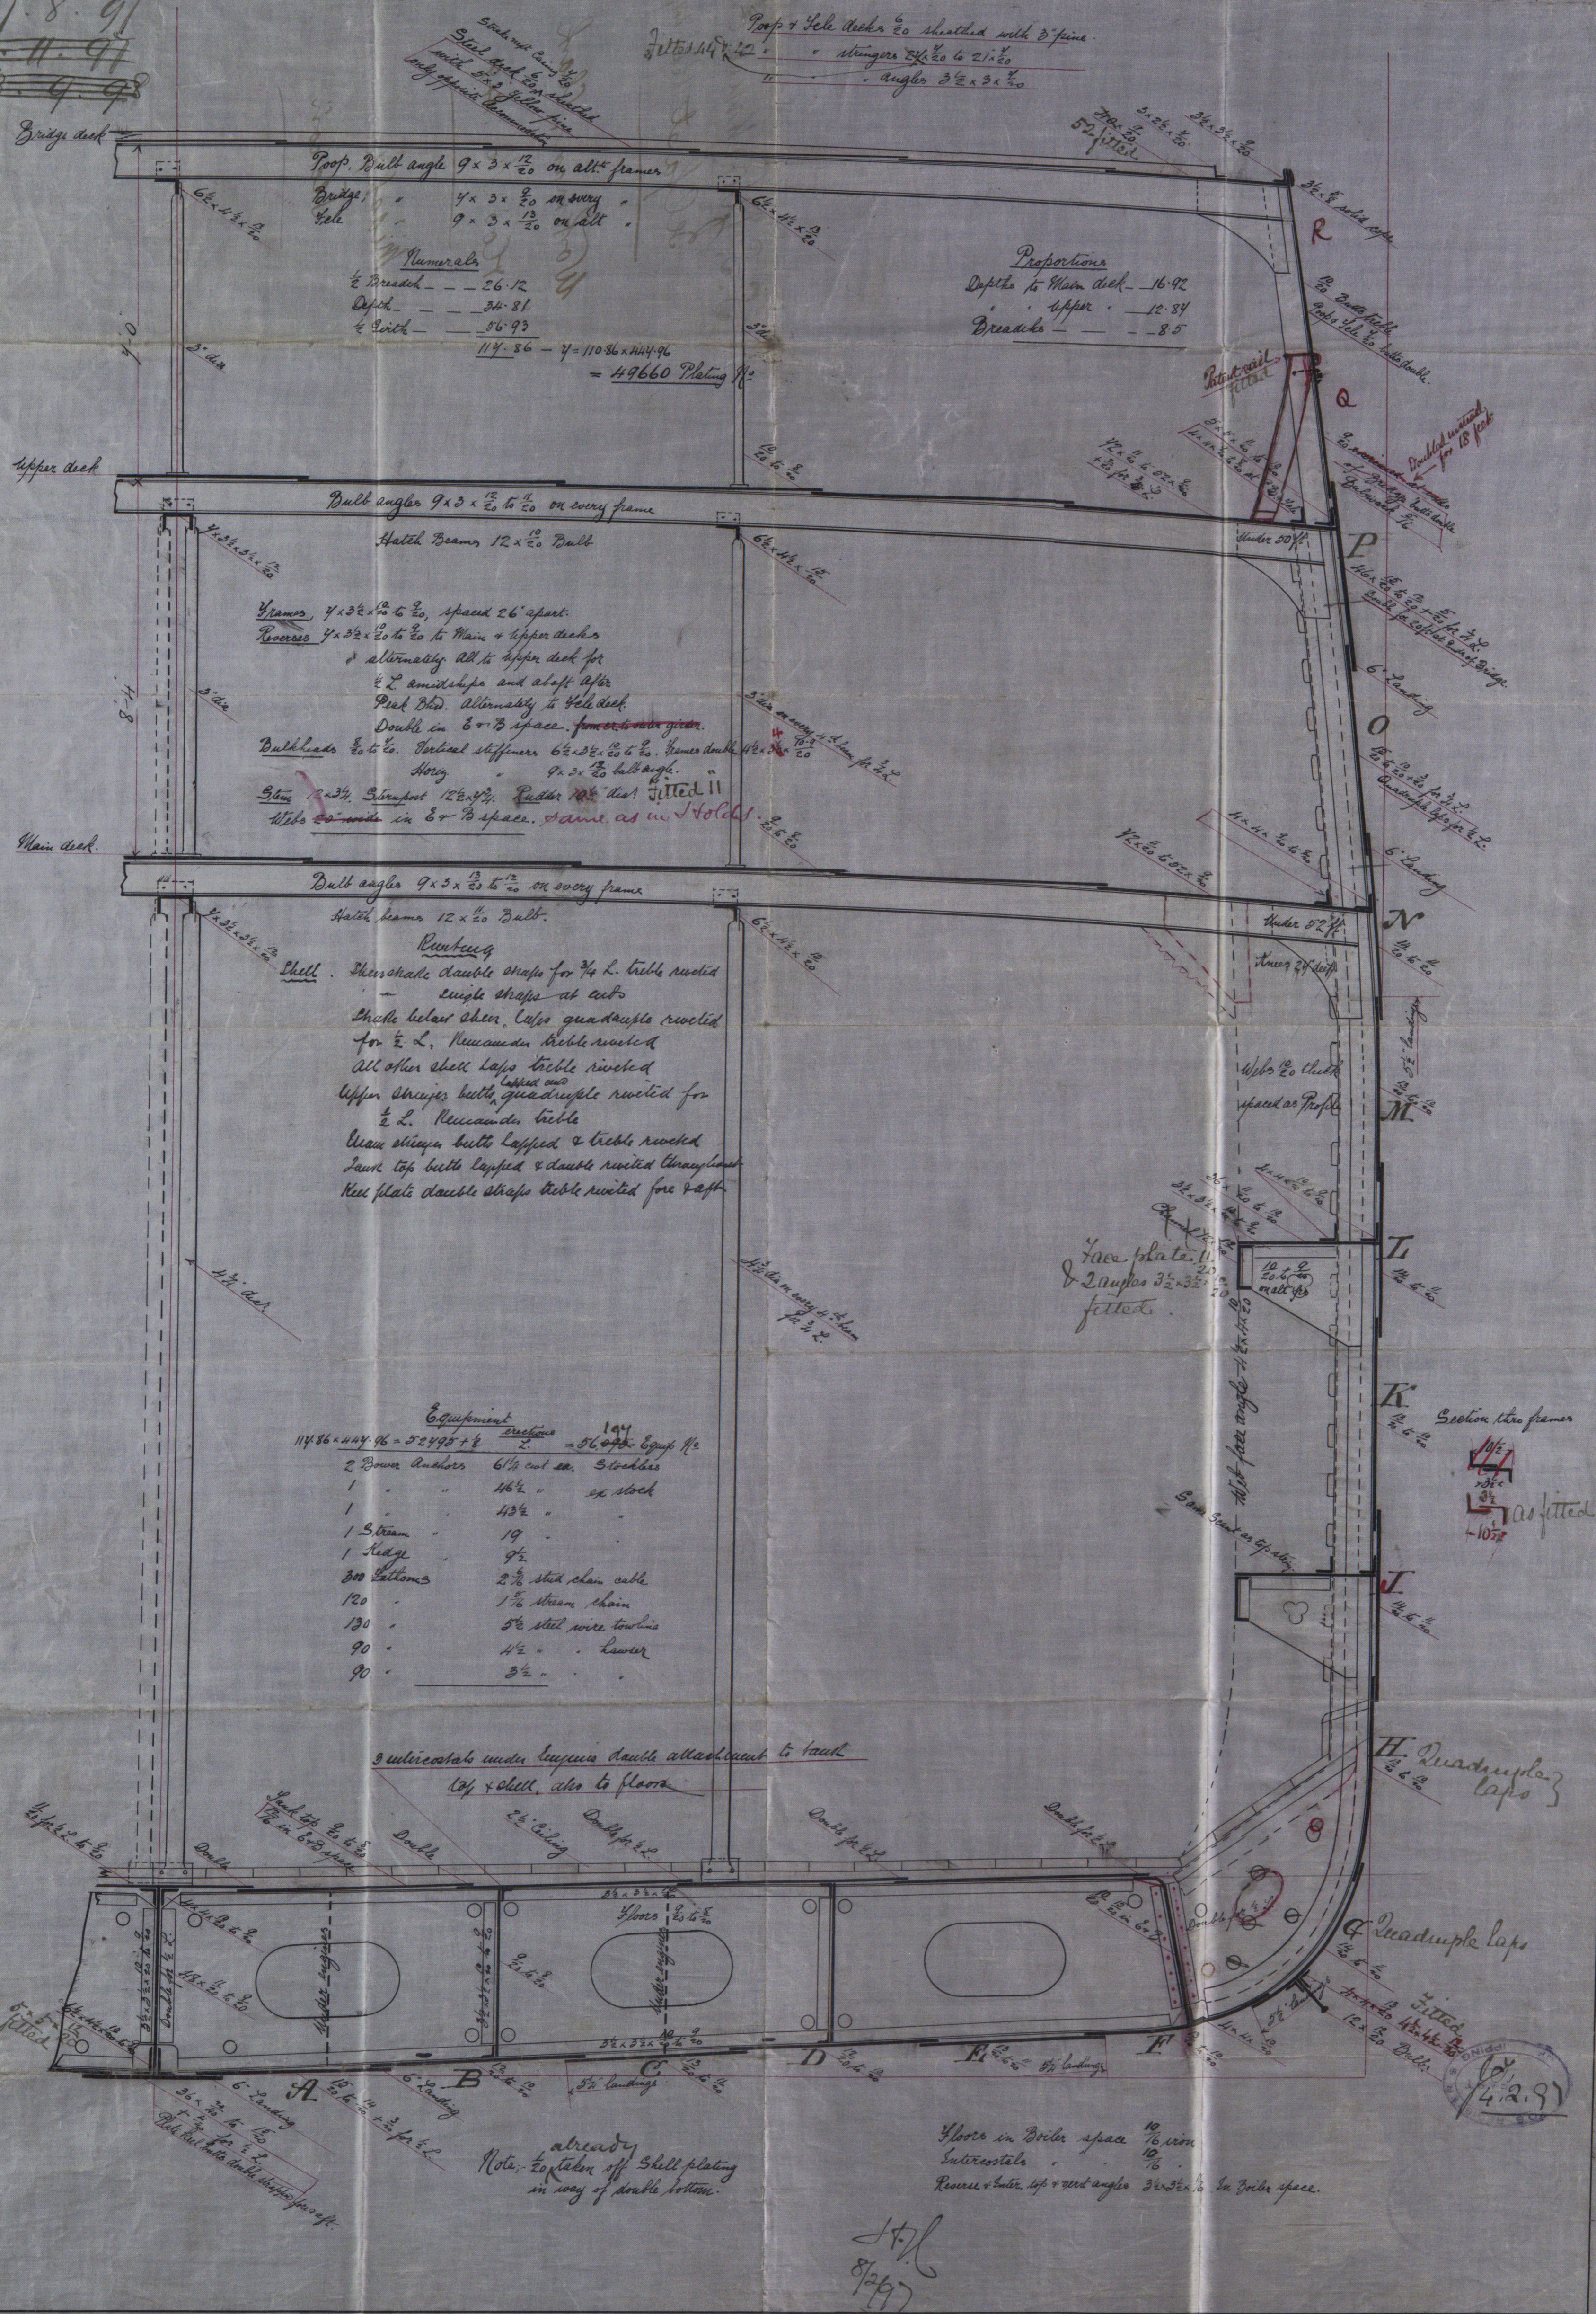









S. S. Workman
 Belfast Rept 49-17

Workman, Clark

No. 149

Miss



© 2019

Lloyd's Register
Foundation