

Lloyd's Register of British and Foreign Shipping.

(Report on Vessel No. _____ Port _____)

No. 5789 SHIP FORGINGS OR CASTINGS.

The words FORGINGS or CASTINGS, IRON or STEEL, should be struck out as may be required.

I have to report that the undermentioned Iron ~~or Steel~~ Forgings ~~or Castings~~,
manufactured by Mess Robt Kerr & Sons
of Glasgow for the Vessel No. 149, being built
by Mess Workman Clark & Co of Belfast
have been inspected by me as set forth below, and found to be, so far as can be seen,
Sound & efficient


Mark on Forgings.

Lloyd's
No. 5789
W.H.

William Hamilton
Glasgow 13/10/98

	STERN FRAME.	RUDDER FRAME.	STEM.
Material*		<u>Scrap iron</u>	
How made		<u>Forged</u>	
Dimensions		<u>11 to 8 1/2 x 5 1/2</u>	
Progress on Inspection		<u>Forging & smithing</u>	
Date when Inspected		<u>6/8/97 to 12/10/98</u>	

SKETCHES OF FRAMES SHOWING POSITION AND DESCRIPTION OF WELDS OF FORGINGS, OR PARTICULARS OF TESTS APPLIED TO CASTINGS.

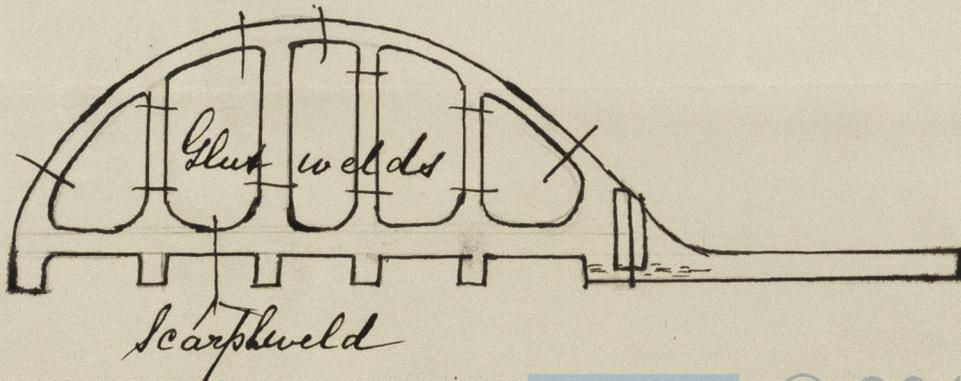

Fee (if any chargeable) £ : :

To be paid at _____



© 2019

Lloyd's Register
Foundation

2.0712⁰⁰ - 148 Workman

Ship forging (Rudder)

13/10/98



© 2019

Lloyd's Register Foundation

[Handwritten signature]