
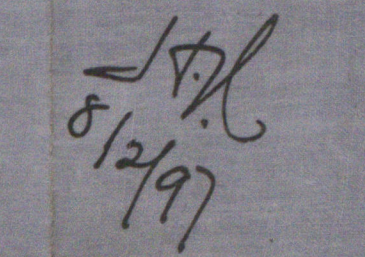


Scale  $\frac{1}{8}'' = 1 \text{ foot}$ .



Lloyd's Register Foundation

Belfast Sept 4

Workman Clark

Box No 49

Proposed Method

of fitting

Web frames

© 2014

Lloyd's Register  
Foundation